

LAND CORNER RECORDATION CERTIFICATE  
Filing Requirement of Act 74, Mich. P.A. 1970

For corners in  
AURELIUS TOWNSHIP,  
INGHAM COUNTY

Located In:	T 2N R 2W	Corner Code #	C-7
	T R		
	T R		
	T R		
	T R		
	T R		
	T R		
	T R		
	T R		
	T R		

- 1. Public Land Survey
- 2. Property Controlling in Section
- 3. Miscellaneous Property in Sec.

**FILED**  
9:00:50 AM  
11/22/1996 13:34:45  
REGISTER OF DEEDS  
Paula Johnson  
INGHAM COUNTY, MI

Register of Deeds Stamp & File Number

- 4. Lot No. \_\_\_\_\_, Recorded Plat \_\_\_\_\_
- 5. Private Claims \_\_\_\_\_

I, Maurice H. Mahieu, in a field survey on October 25, 1996 do hereby state that under requirements of P.A. 74, Michigan P.A. of 1970, the corner points mentioned in lines 1 and 2 above were in conformance with regulations and rules therefore as required in the current manual of survey instructions of the United States Department of the Interior, Bureau of Land Management or by a decree of a Court of Law and/or that the corner points mentioned in lines 3, 4 and 5 above were in conformance with the rules of the Michigan Board of Land Surveyors or by a Decree of a Court of Law; established, re-established, monumented, recovered, found as expressed below:

A	B	C	D	E	F	G	H	I	J	K	L
1											
2	6		5		4		3		2		1
3											
4	7		8		9		10		11		12
5											
6	18		17		16		15		14		13
7											
8	19		20		21		22		23		24
9											
10	30		29		28		27		26		25
11											
12	31		32		33		34		35		36
13											

**NOTE: Not more than 2 corners, all in the same town and range, may be recorded on this certificate.**

A. Description of original monument and accessories and/or subsequent restoration:

- 1. The Original GLO corner was set by H. Parke in Feb. 1826 as "Set P cor 17, 18, 19 & 20 Fw Be 20 N80E 12 Be 14 S67W 27"
- 2. County Surveyor A. Jackson on February 11, 1852 used corner. No corner material noted; witnessed by: Be 20 N80E 12 Do 14 S67W 27 Record in Book 1, Page 269
- 3. County Surveyor A. Jackson on December 21, 1854 used corner. No corner material noted; calls for same witnesses as A-2. Recorded in Book 1, Page 383.

See Part A continued on back

B. Description of corner evidence found and/or method applied in restoring or reestablishing corner:


Found 5/8" x 1.2' iron rebar in monument box 2' north of centerline of Bunker Road and in centerline Gale Road. Top of rebar bent. Found Nail and Tag #18998 on west side utility pole S41°E 66.32 feet, Nail and Tag North side Utility Pole S41°E 66.32 feet, Nail and Bottle Cap NE side Utility Pole N41°E 66.59 feet and Nail and Tag #18998, East side 24" Cherry S19°W 77.18 feet. Measurements to top of rod. Removed and excavated 2' x 2' hole thru 2 1/2" asphalt. Found large pointed stone south and adjacent to rebar. Found pieces of brick surrounding pointed stone. Stone too large to remove. Bottom of 5/8" rebar over pointed stone. Set 3/4" x 24" iron rod with cap stamped "PA 345, PS 28414 in location of bottom of rod over pointed stone. The stone assumed to be the point set by previous County Surveyors and the rod is the perpetuation of the corner position.

C. Description of monument for corner and accessories established to perpetuate locating the position of the corner:

Set 3/4" x 24" iron rod with cap stamped "PA 345 PS #28414" with monument box. Witnessed by:  
Nail and Tag #18998 West side Utility Pole S41°E 66.53 feet  
Nail and Tag #18998 East side 24" Cherry S19°W 77.47 feet  
Nail and Tag #28414 West side 28" Maple S6°E 281.88 feet  
Nail and Tag #28414 North side Utility Pole S76°W 229.11 feet

Signed by Maurice H. Mahieu Date 11-15-96

Surveyor's Michigan License No. 28414

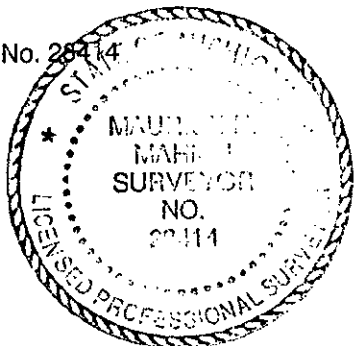

P.A. 345 INGHAM COUNTY  
PEER APPROVED 11/14/96 *ML*

Part A Continued

- 4. County Surveyor A. Jackson used corner no date recorded. No corner material noted; witnessed by:  
Beech 20 N50E 12  
Do 14 S67W 27  
Recorded in Book 1, Page 384
- 5. County Surveyor T. J. Brown on April 9, 1868 used corner.  
Notes "(1) Apple 4 in diam. Bears N38°W 108 1/3 lks  
Sugar 6 in diam. N 75 1/2°E 18 3/4 lks
- 6. County Surveyor T. J. Brown on April 10, 1868 used corner.  
Notes "(5) Apple 4 in diam. Bears N38°W 108 1/3 lks  
Sugar 5 in diam. Bears S22 3/4°W 50 3/4 lks  
Recorded in Book 2, Page 57
- 7. An Act 132 survey in Liber 1, Page 442 recorded by Ron Helsel PS S#18994 on October 10, 1972 calls for a RR spike at surface of aspha centerline Bunker Road. Witnessed by:  
S 25°W 77.62' 12" Wild Cherry  
S 45°W 40.77' 12" Wood Anchor Post  
S 45°E 66.60' Power Pole
- 8. LCRC recorded in Liber 2, Page 97 by Ron Helsel PS #18994 on October 10, 1972 calls for same corner and witnesses as A-7.
- 9. An Act 132 survey in Liber 2, Pages 929, 930 recorded by Laverne Hendryx PS #3276 on November 13, 1976 shows corner but does not have any material or witnesses given.
- 10. An Act 132 survey in Liber 6, Pages 161, 162, 163 recorded by Larry Bryan PS #25832 on May 18, 1990 calls for a RR spike pointed rock the intersection of roads. Witnessed by:  
Nail and bottle cap in NE side Power Pole S45°E 66.6'  
Nail and White Tag in North side Power Pole S45°E 66.3'  
Nail and Tag #25832 in East side 24" Cherry S25°W 77.3'
- 11. An Act 132 survey in Liber 6, Pages 822, 833 recorded by Marvin Fouty PS #18989 on October 11, 1991 calls for a nail in stone. Witnesses given.
- 12. An Act 132 survey in Liber 7, Pages 500, 501 recorded by Ronnie Lester PS #18998 on February 8, 1995 calls for a 5/8" bar in monume box witnessed by:  
Nail and Tag #18998 on West side Utility Pole Mag. Az. 143° 66.49'  
Nail and Tag #18998 on East side 24" Cherry Mag. Az. 204° 77.28'  
Nail and Tag #18998 on West side Utility Pole Mag. Az. 92.23° 239.05'  
Centerline of top of catchbasin Mag. Az. 194° 146.52'
- 13. Ingham County Road Commission grid maps shows corner as stone witnessed by:  
12" Box Elder SE 44.9'  
12" Cherry SSW 77.6'  
Anch. Post SW 41.0'  
Road Sign NE 39.75'

IMPROVED COPY  
 1995  
 SERIES OF DEEDS  
 11551789 13:30:00  
 00002031  
 RECORDED  
**FILED**

1995  
 2 1995  
 25