

For corners in
AURELIUS TOWNSHIP,
INGHAM COUNTY

Located In:	Corner Code #
T 2N R 2W	C-10
T R	
T R	
T R	
T R	
S T R	
S T R	
S T R	
S T R	

FILED

960045029
11/22/1996 13:34:37
REGISTER OF DEEDS
Paula Johnson
INGHAM COUNTY, MI

1. Public Land Survey

2. Property Controlling
in Section

3. Miscellaneous
Property in Sec.

4. Lot No. _____, Recorded Plat _____
5. Private Claims _____

Register of Deeds Stamp & File Number

A	B	C	D	E	F	G	H	I	J	K	L	M
1												
2	6		5		4		3		2		1	
3												
4	7		8		9		10		11		12	
5												
6	18		17		16		15		14		13	
7												
8	19		20		21		22		23		24	
9												
10	30	29			28		27		26		25	
11												
12	31		32		33		34		35		36	
13												

I, Maurice H. Mahieu, in a field survey on October 25, 1996 do hereby state that under requirements of P.A. 74, Michigan P.A. of 1970, the corner points mentioned in lines 1 and 2 above were in conformance with regulations and rules therefore as required in the current manual of survey instructions of the United States Department of the Interior, Bureau of Land Management or by a decree of a Court of Law and for that the corner points mentioned in lines 3, 4 and 5 above were in conformance with the rules of the Michigan Board of Land Surveyors or by a Decree of a Court of Law; established, re-established, monumented, recovered, found as expressed below:

NOTE: Not more than 2 corners, all in the same town and range, may be recorded on this certificate.

A. Description of original monument and accessories and/or subsequent restoration:
1. The Original GLO corner was set by Harvey Parke in Feb. 1826 as set post at 40.0 chains; witnessed by: Beech 10, S3W 10; Beech 14, N32E 13

2. County Surveyor Thomas J. Brown recorded a survey on January 27, 1866 in Book 2, Page 28. Calls "11" the east quarter post of said section being in the highway, no witness trees"

3. County Surveyor T. J. Brown recorded a survey on April 20, 1870 in Book 2, Page 77. Notes " 11 post, no trees a stone ordered to be set for the corner.

See Part A continued on back

B. Description of corner evidence found and/or method applied in restoring or reestablishing corner:

Found 1/2" rod and 4" concrete monument 1.5'± west of centerline Gale Road. Found following witnesses: Nail and tag #18998 East side 21" Maple S85°E 30.23 feet; Nail hole in NE side dead twin cherry, West 66.10 feet; Nail and tag #18998 East side 15" Basswood S26°W 45.34 feet (15" Basswood in easterly tree of large Basswood clump. Ron Lester calls this tree a 10" Ash in LCRC Liber 4, Page 374). Centerline 38" Oak S10°W 136.3'±. Excavated around concrete monument and found concrete collar. Removed collar and set monument box and top over concrete monument. Set cap stamped PA 345, PS #28414 on top of concrete monument. The location of the monument is believed to be T. J. Brown's corner and is the best position for the corner.

C. Description of monument for corner and accessories established to perpetuate locating the position of the corner:

1/2" rod in 4" concrete monument with cap stamped PA 345, PS #28414 witnessed by:
Nail and tag #18998 South side 21" Maple S85°E 30.23 feet
Nail and tag #28414 North side Twin Maple N89°W 72.64 feet
Nail and tag #28414 East side 38" Oak, S10°W 135.90 feet
Nail and tag #28414 East side Basswood clump, S26°W 45.27 feet


Signed by Maurice H. Mahieu

Date 11-11-96

Surveyor's Michigan License No. 28414

FORM APPROVED BY MICHIGAN STATE BOARD OF PROFESSIONAL SURVEYORS, JAN 28, 1971
REVISED MAY 14, 1975

REVISED JAN, 1983
REVISED OCT., 1993

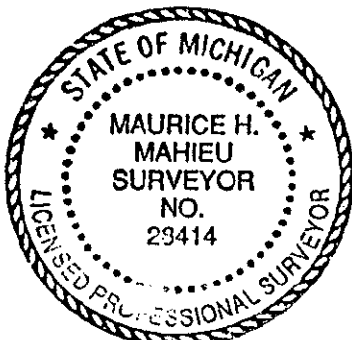

P.A. 345 INGHAM COUNTY
PEER APPROVED 10/31/96 *ML*

Part A continued

4. A LCRC was recorded on September 19, 1978 in Liber 4, Page 374 by Ronnie Lester PS #18998 and Gary Lester PS #17624 as a result of Ingham County Remonumentation project. A 5'x7' hole was excavated to an average depth of 4' in centerline of Gale Road. Found 2 1/2' x 1' blue stone surrounded by 8 smaller stones with a 1" x 1/2" x 1' wooden stake below blue stone. Set 4" x 36" concrete monument with #18998 and concrete collar in location of stake. Witnessed by:

- Nail and tag #18998 Southwest side 12" Maple East 29.85 feet
- Nail and tag #18998 Northeast side 10" Ash Southwest 45.55 feet
- Nail and tag #18998 Northeast side Twin Wild Cherry West 66.21 feet
- Nail and tag #18998 East side 24" Oak SSW 136.41 feet

5. Ingham County Road Commission grid maps calls for a stone witnessed by anchor post 26.6' East

