

REMONUMENTATION

DEC 1 2 1997

LAND CORNER RECORDATION CERTIFICATE
Filling Requirement of Act 74, Mich. P.A. 1970

Liber 9 Page 248

COMMISSION

For corners in

<u>INGHAM</u>	Located in:	Corner Code #
(County)		
AURELIUS TOWNSHIP	<u>T 2N R 2W</u>	<u>C-12</u>
1. Public Land Survey	T <u> </u> R <u> </u>	<u> </u>
	T <u> </u> R <u> </u>	<u> </u>
	T <u> </u> R <u> </u>	<u> </u>
2. Property Controlling	S <u> </u> T <u> </u> R <u> </u>	<u> </u>
in Section	S <u> </u> T <u> </u> R <u> </u>	<u> </u>
3. Miscellaneous	S <u> </u> T <u> </u> R <u> </u>	<u> </u>
Property in Sec.	S <u> </u> T <u> </u> R <u> </u>	<u> </u>


FILED
970041265
10/20/1997 16:12:55
REGISTER OF DEEDS
Paula Johnson
INGHAM COUNTY, MI

Register of Deeds Stamp & File Number

4. Lot No. _____, Recorded Plat _____
5. Private Claims _____

I, DAVID L. CLIFFORD, in a field survey on APRIL 10, 1997 do hereby state that under requirements of P.A. 74, Michigan P.A. of 1970, the corner points mentioned in lines 1 and 2 above were in conformance with regulations and rules therefore as required in the current manual of survey instructions of the United States Department of the Interior, Bureau of Land Management or by a decree of a Court of Law and for that the corner points mentioned in lines 3, 4 and 5 above were in conformance with the rules of the Michigan Board of Land Surveyors or by a Decree of a Court of Law, established, re-established, monumented, recovered, found as expressed below:

NOTE: Not more than 2 corners, all in the same town and range, may be recorded on this certificate.

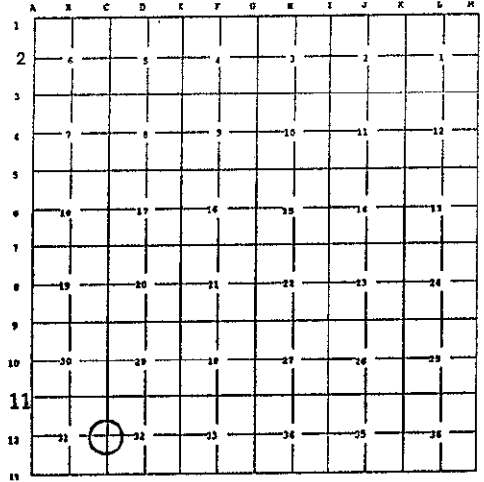

- A. Description of original monument and accessories and/or subsequent restoration:
1. ORIGINAL POST SET BY HERVEY PARKE D.S. FEB. 1826.
TAM. 14" S4E 250(165.0')
B.ASH 12" N1/2E 4.80(316.8')
 2. A. JACKSON CO. SURVEYOR USED CORNER IN SURVEY RECORDED IN VOL. 1 PAGE 40 IN MARCH 1839 WITH SAME MONUMENT AND WITNESSES AS GLO.
 3. T.J. BROWN CO. SURVEYOR USED CORNER IN JAN 1866 WITH SAME WITNESSES AS A-1.
 4. R. HELSEL LS 18989 SET 1/2" IRON BAR MIDWAY AND ON LINE L4 PG 82 ACT 74 AUG. 77.
EAST 39.20' CENTERLINE 6' X 2" PIPE
S80W 31.57' NAIL AND TAG IN 6" WILLOW
NORTH 43.27' P.K. NAIL IN CENTERLINE OF GALE RD.
 5. M. MAHIEU LS 28414 USED CORNER IN AN ACT 132 SURVEY RECORDED L. 7 PAGE 629 IN MARCH 1995.
WEST 19.09' S. SIDE WOOD POST
N15°E 48.80' NAIL AND TAG #28414 IN W. SIDE WOOD POST
N10°E 86.23' NAIL AND TAG #28414 IN W. SIDE 18" ELM
S60°E 14.98' NAIL AND TAG #28414 IN W. SIDE WOOD POST

B. Description of corner evidence found and/or method applied in restoring or reestablishing corner:

SEARCHED AT APPARENT LOCATION OF CORNER AND FOUND 1/2" BAR 2' EAST OF CENTERLINE OF GALE ROAD ON VERY VAGUE OCCUPATION LINE EAST AND WEST. AS CORNER FALLS IN 4'+- OF ROAD FILL IN A SWAMP, CHANCES OF FINDING HISTORICAL EVIDENCE ARE ZERO. AFTER TRAVERSING ALL OF SECTION 31 ACCEPTED 1/2" BAR AS AN HONEST ATTEMPT AT A LOST CORNER RE-ESTABLISHMENT OF CORNER AND REPLACED IT WITH STANDARD INGHAM COUNTY REMONUMENTATION AND SET MONUMENT BOX. MEASURED SOUTH 2657.30' TO C-13. MEASURED NORTH 2658.51' TO C-11. MEASURED WEST 2651.76' TO B-12.

C. Description of monument for corner and accessories established to perpetuate locating the position of the corner:

C-12 T2N R2W
3/4" X 24" STEEL BAR AND YELLOW PLASTIC CAP IMPRINTED PA345 PS25837 IN MONUMENT BOX.
NAIL AND TAG # 28414 IN WEST SIDE GUARD POST, 17° NAZ., 48.82'
6' X 1-1/4" PIPE, 97° NAZ., 39.20'
1/2" BAR AND CAP # PS28414, 274° NAZ., 33.03'
SET NAIL AND TAG # 25837 IN NORTH SIDE OF 8" WALNUT, 286° NAZ., 225.66'
SET NAIL AND TAG # 25837 IN NORTH SIDE OF 14" OAK, 298° NAZ., 237.18'
SET NAIL AND TAG # 25837 IN NORTHWEST SIDE OF 12" OAK, 307° NAZ., 231.94'
SET NAIL AND TAG # 25837 IN NORTHEAST SIDE OF 8" DOUBLE WALNUT, 320° NAZ., 190.25'



Signed by David L. Clifford Date JUNE 2, 1997
Surveyor's Michigan License No. 25837

P.A. 345 INGHAM COUNTY
PEER APPROVED 6/2/97 MC