

DEC 1 2 1997

COMMISSION

LAND CORNER RECORDATION CERTIFICATE  
Filing Requirement of Act 74, Mich. P.A. 1970

For corners in

Liber 9 Page 249

<u>INGHAM</u> (County)	Located In:	Corner Code #
AURELIUS TOWNSHIP	T <u>2N</u> R <u>2W</u>	<u>C-13</u>
1. Public Land Survey	T <u>   </u> R <u>   </u>	<u>   </u>
	T <u>   </u> R <u>   </u>	<u>   </u>
	T <u>   </u> R <u>   </u>	<u>   </u>
2. Property Controlling in Section	S <u>   </u> T <u>   </u> R <u>   </u>	<u>   </u>
	S <u>   </u> T <u>   </u> R <u>   </u>	<u>   </u>
3. Miscellaneous Property in Sec.	S <u>   </u> T <u>   </u> R <u>   </u>	<u>   </u>
	S <u>   </u> T <u>   </u> R <u>   </u>	<u>   </u>

FILED


970041266  
10/20/1997 16:12:57  
REGISTER OF DEEDS  
Paula Johnson  
INGHAM COUNTY, MI

Register of Deeds Stamp & File Number

4. Lot No. \_\_\_\_\_, Recorded Plat \_\_\_\_\_  
5. Private Claims \_\_\_\_\_

I, DAVID L. CLIFFORD, in a field survey on OCT. 10, 1996 do hereby state that under requirements of P.A. 74, Michigan P.A. of 1970, the corner points mentioned in lines 1 and 2 above were in conformance with regulations and rules therefore as required in the current manual of survey instructions of the United States Department of the Interior, Bureau of Land Management or by a decree of a Court of Law and/or that the corner points mentioned in lines 3, 4 and 5 above were in conformance with the rules of the Michigan Board of Land Surveyors or by a Decree of a Court of Law; established, re-established, monumented, recovered, found as expressed below.

NOTE: Not more than 2 corners, all in the same town and range, may be recorded on this certificate.

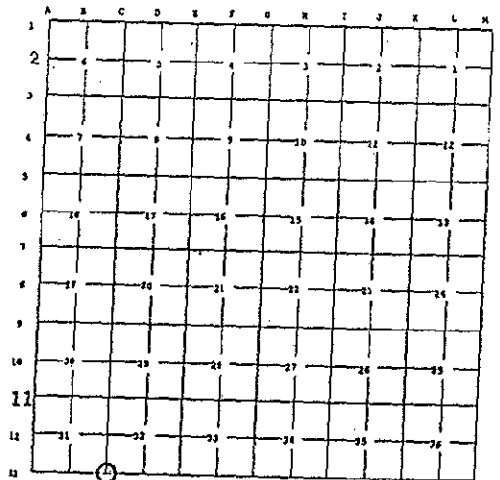

A. Description of original monument and accessories and/or subsequent restoration:

1. ORIGINAL POST SET BY JOHN MULLET D.S. MAY 1825.  
W.O. 30" N19W 5.74(378.8')  
B.O. 10" N80-1/2E 508(335.3')
2. A. JACKSON CO. SURVEYOR USED CORNER IN SURVEY RECORDED IN VOL. 1 PAGE 40 IN MARCH 1839.  
W.O. 6" N60W 44(29.0')
3. A. JACKSON CO. SURVEYOR USED CORNER IN SURVEY RECORDED IN VOL. 2 PAGE 112 IN FEB 1852 WITH TWO WITNESSES:  
B. O. 10" N80-1/2E 508(335.3')  
BEECH 11" S62W 32-1/2(21.5')
4. R.J. ROBB CO. SURVEYOR USED CORNER IN A SURVEY RECORDED IN VOLUME 5 PAGE 272 AN 1910 AS A STONE.  
S.E. CORNER OF HOUSE NW 93'  
W. OAK 15" SE 66'

(CONTINUED ON BACK)

B. Description of corner evidence found and/or method applied in restoring or reestablishing corner:

SEARCHED AT APPEARENT LOCATION OF CORNER AND FOUND 1/2" BAR 3' NORTH OF CENTERLINE OF PLAINS ROAD AND 10' WEST OF C-1, T1N, R2W WHICH LIES ON THE CENTERLINE OF GALE ROAD. THIS POSITION MATCHES ROBB'S FOUNDATION WITNESS, HELSEL'S FOUNDATION WITNESS TO A DIFFERENT CORNER OF SAME HOUSE THAT ROBB USED AND ALL OF MAHIEW'S WITNESSES. EXCAVATED 18" DIAMETER HOLE 2' DEEP AND FOUND POINTED SANDSTONE UNDER IRON. ACCEPTED STONE AS PERPETUATION OF CORNER AND REPLACED 1/2" BAR WITH STANDARD INGHAM COUNTY REMONUMENTATION 3/4" BAR AND PA 345 CAP. PLACED MONUMENT BOX. MEASURED NORTH 2657.30' TO C-12. MEASURED WEST 2651.05' TO B-13.

C. Description of monument for corner and accessories established to perpetuate locating the position of the corner:

C-13 T2N R2W  
3/4" X 24" STEEL BAR AND YELLOW PLASTIC CAP IMPRINTED PA345 PS25837 IN MONUMENT BOX.  
SET NAIL AND TAG # 25837 IN NORTH SIDE UTILITY POLE, 124° NAZ., 164.95'  
1/2" BAR IN CONCRETE, 220° NAZ., 39.80'  
3/4" BAR AND PA 345 # PS25837 CAP IN MONUMENT BOX (C-1, T1N R2W), 95° NAZ., 10.05'  
FOUND NAIL AND TAG # 28414 IN SOUTH SIDE UTILITY POLE, 298° NAZ., 77.90'  
FOUND NAIL AND TAG # 28414 IN EAST SIDE OF 28" OAK, 205° NAZ., 48.48'  
S.E. CORNER FOUNDATION HOUSE #6008, 325° NAZ., 93.10'  
S.W. CORNER POLE BARN, 34° NAZ., 182.90'



Signed by David L. Clifford

Date SEPTEMBER 25, 1997

Surveyor's Michigan License No. 25837

5. FRED WHITE LS 12034 RECORDED CORNER IN LIBER 1 PAGE 437, LIBER 1 PAGE 461, AND LIBER 3 PAGE 49. HE ALSO USED CORNER IN AN ACT 132 SURVEY AS A FOUND 1/2" BAR  
24" BOX ELDER N60°W 63.0  
36" OAK S62°E 56.03'  
20" MAPLE S32°W 49.6'
6. R. HELSEL LS 18994 RECORDED CORNER IN LIBER 4 PAGE 83 AND USED CORNER IN AN ACT 132 SURVEY'S RECORDED IN LIBER 3 PAGE 1217 AND LIBER 7 PAGE 336 AS A SET 1/2" BAR AND CAP 9.9' WEST OF C-1 T1N R2W (IRON RECORDED AS C-13 IN ITEM A-5)  
N45°W 89.00' SE'LY CORNER OF HOUSE FOUNDATION  
N50°W 53.42' NAIL AND TAG IN 20" BOX ELDER  
N45°W 36.77' NAIL AND TAG IN 18" MAPLE  
S45°E 66.55' NAIL AND TAG IN 36" OAK
7. M. MAHIEU LS 28414 USED CORNER IN AN ACT 132 SURVEYS RECORDED IN LIBER 7 PAGE 361 AND PAGE 761 AS A FOUND 1/2" IRON  
N&T #18414 E. SIDE UTILITY POLE S45°W 95.35,  
N&T #18414 E. SIDE 36" OAK S20°W 48.58'  
N&T #18414 S. SIDE UTILITY POLE N75°W 78.00'  
1/2" IRON W/CAP IN MONUMENT BOX EAST 9.92'