

COMMISSION

LAND CORNER RECORDATION CERTIFICATE  
Filing Requirement of Act 74, Mich. P.A. 1970

LIBER 8 PAGE 207

FILED

For corners in

<u>INGHAM</u> <small>(County)</small>		Located In:	Corner Code #
<u>AURELIUS TOWNSHIP</u>			
1. Public Land Survey	T <u>2N</u> R <u>2W</u>		<u>I-2</u>
	T _____ R _____		_____
	T _____ R _____		_____
	T _____ R _____		_____
2. Property Controlling in Section	S _____ T _____ R _____		_____
	S _____ T _____ R _____		_____
3. Miscellaneous Property in Sec.	S _____ T _____ R _____		_____
	S _____ T _____ R _____		_____
4. Lot No. _____, Recorded Plat _____			
5. Private Claims _____			

SEP 13 12 02 PM '94

REGISTER OF DEEDS  
INGHAM COUNTY, MICH.

Register of Deeds Stamp & File Number

I, RONALD L. ENGER, in a field survey on AUGUST 19, 1993, do hereby certify that under requirements of P.A. 74, Michigan P.A. of 1970, the corner points mentioned in lines 1 and 2 above were in conformance with regulations and rules therefore as required in the current manual of survey instructions of the United States Department of the Interior, Bureau of Land Management or by a decree of a Court of Law and/or that the corner points mentioned in lines 3, 4 and 5 above were in conformance with the rules of the Michigan Board of Land Surveyors or by a Decree of a Court of Law; established, re-established, monumented, re-monumented, recovered, found as expressed below:

NOTE: Not more than 4 corners, all in the same town and range, may be recorded on this certificate.

A	B	C	D	E	F	G	H	I	J	K	L
2	5	5	4	3	2						
3											
4	7	8	9	10	11	12					
5											
6	18	17	16	15	14	13					
7											
8	19	20	21	22	23	24					
9											
10	30	29	28	27	26	25					
11											
12	31	32	33	34	35	36					
13											

A. Description of original monument and accessories and/or subsequent restoration:

1. POST SET IN ORIGINAL GOVERNMENT SURVEY BY HERVEY PARKE, DEPUTY SURVEYOR ON FEBRUARY 7, 1826 WITH THE FOLLOWING WITNESSES:  
W. ASH 5 S55E 34 (22.4')  
MAPLE 7 N33W 13-L/2 (8.9')


CONTINUED ON BACK

B. Description of corner evidence found and/or method applied in restoring or reestablishing corner:

SEARCHED AREA OF CORNER AND FOUND 1/2" BAR AND CAP #18998 IN MONUMENT BOX. FOUND 1 REMAINING R. LESTER WITNESS, TAG IN 5" POST EAST 33.0', AND THIS WITNESS FITS POSITION OF CORNER. GEORGE YOUNG SURVEY CALLS FOR A DISTANCE OF 2662.81 TO I-1 AGREEING CLOSELY WITH ICRC INFORMATION OF 1964. CORNER AS MONUMENTED MATCHES GLO PRORATION ALMOST PERFECTLY. BELIEVE MONUMENT IS BEST AVAILABLE EVIDENCE OF LOCATION OF CORNER AS DESCRIBED BY ANSON JACKSON IN 1854. ACCEPTED 1/2" BAR AND CAP AS CORNER. MEASURED NORTH 2662.86 FEET TO I-1, MEASURED EAST 2663.14 FEET TO J-2, MEASURED SOUTH 2643.12 FEET TO I-3. REPLACED 1/2" BAR WITH STANDARD INGHAM COUNTY REMONUMENTATION MARKER.

C. Description of monument for corner and accessories established to perpetuate locating the position of the corner:

3/4" SMOOTH STEEL BAR AND P.A. 345 CAP #28409 IN MONUMENT BOX  
SET NAIL AND TAG #28409 IN EAST SIDE 12" WILLOW, AZ 195°, 122.14'  
SET NAIL AND TAG #28409 IN WEST SIDE TWIN 15" WILLOW, AZ 162°, 117.32'  
SET NAIL AND TAG #28409 IN TOP 5" WOOD POST, AZ 92°, 33.09'  
SET NAIL AND TAG #28409 IN WEST SIDE POWER POLE, AZ 170.86  
CENTERLINE AURELIUS ROAD EAST 4.6'

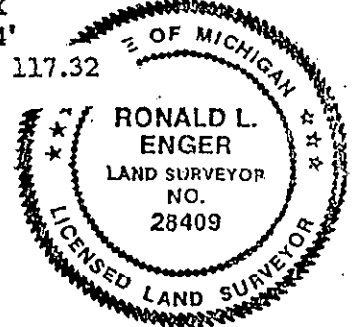

Signed by Ronald L. Enger Date JULY 27, 1994  
Surveyor's Michigan License No. 28409

I-2 T2N R2W  
PART A CONTINUED

2. ANSON JACKSON, COUNTY SURVEYOR, REPORTED USING CORNER IN A SURVEY DATE MAY 4, 1846 AND RECORDED IN MISC. FIELD NOTES PAGE 20, COUNTY SURVEYORS RECORDS WITH NO MENTION OF MONUMENT AND THE FOLLOWING WITNESSES:  
BEECH 8, S44W 27-3/4 (18.3')  
SUGAR 27 S12-3/4E 22-3/4 (15.0')

3. ANSON JACKSON AGAIN REPORTED USING CORNER IN A SURVEY DATED DECEMBER 19, 1854 WITH NO MENTION OF MONUMENT AND THE FOLLOWING WITNESSES:  
LYNN 16 N83-1/2E 16 (10.6'),  
HICKORY 22" N85-1/2W 36 (23.8')

4. INGHAM COUNTY ROAD COMMISSION INFORMATION FROM 1964 CALLS FOR A DISTANCE OF 2662.84' FROM I-1 NAIL AND TAG IN EAST SIDE 4" ASH SSW 58.18'

5. RONNIE M. LESTER LS #18998 REPORTED USING CORNER ON JUNE 20, 1975 AND RECORDED IN LIBER 2 OF SURVEYS PAGE 242, INGHAM COUNTY RECORDS AS A 1/2" BAR AND CAP IN MONUMENT BOX WITH THE FOLLOWING WITNESSES:  
NAIL AND TAG IN EAST SIDE 8" POPLAR, NNW 106.16'  
NAIL AND TAG IN SOUTH SIDE 5" POST EAST 33.0'  
NAIL AND TAG IN EAST SIDE 4" ASH SSW 58.18'

6. RONNIE M. LESTER LS #18998 RECORDED CORNER ON MARCH 16, 1978 IN LIBER 4 OF CORNERS, PAGE 160, AS A SET 1/2" BAR AND CAP IN MONUMENT BOX IN ACCORDANCE WITH INGHAM COUNTY ROAD COMMISSION RECORD DIMENSION FROM SOUTH AND ADJACENT DEED DESCRIPTION AND MONUMENTATION WITH THE FOLLOWING WITNESSES:  
NAIL AND TAG IN EAST SIDE 8" POPLAR, NNW 106.10'  
NAIL AND TAG IN SOUTH SIDE 5" POST, EAST 33.0'  
NAIL AND TAG IN EAST SIDE 4" ASH, SSW 58.18'

7. GEORGE M. YOUNG LS #17640 REPORTED USING CORNER ON APRIL 11, 1979 AND RECORDED IN LIBER 3 OF SURVEYS, PAGE 345, INGHAM COUNTY RECORDS AS A 1/2" BAR AND CAP IN MONUMENT BOX WITH THE SAME WITNESSES AS R. LESTER'S LCRC.