

SURVEY &  
REMONUMENTATION

NOV 30 1993

COMMISSION

LAND CORNER RECORDATION CERTIFICATE  
Filing Requirement of Act 74, Mich. P.A. 1970

LIBER 8 PAGE 9  
FILED

For corners in  
INGHAM

(County)  
Aurelius Township

Located In:

Corner Code #

- |                                       |   |           |   |           |            |       |
|---------------------------------------|---|-----------|---|-----------|------------|-------|
| 1. Public Land Survey                 | T | <u>2N</u> | R | <u>2W</u> | <u>I-4</u> |       |
|                                       | T | _____     | R | _____     | _____      |       |
|                                       | T | _____     | R | _____     | _____      |       |
|                                       | T | _____     | R | _____     | _____      |       |
| 2. Property Controlling<br>in Section | S | _____     | T | _____     | R          | _____ |
|                                       | S | _____     | T | _____     | R          | _____ |
| 3. Miscellaneous<br>Property in Sec.  | S | _____     | T | _____     | R          | _____ |
|                                       | S | _____     | T | _____     | R          | _____ |

NOV 4 8 06 AM '93

REGISTER OF DEEDS  
*James J. Johnson*  
INGHAM COUNTY, MICH.

Register of Deeds Stamp & File Number

4. Lot No. \_\_\_\_\_, Recorded Plat \_\_\_\_\_  
5. Private Claims \_\_\_\_\_

	A	B	C	D	E	F	G	H	I	J	K	L	M
2	6	5	4	3	2	1							
3													
4	7	6	5	4	3	2	1						
5													
6	18	17	16	15	14	13							
7													
8	19	20	21	22	23	24							
9													
10	30	29	28	27	26	25							
11													
12	31	32	33	34	35	36							
13													

I, Ronald L. Enger, in a field survey on August 18, 1993, do hereby certify that under requirements of P.A. 74, Michigan P.A. of 1970, the corner points mentioned in lines 1 and 2 above were in conformance with regulations and rules therefore as required in the current manual of survey instructions of the United States Department of the Interior, Bureau of Land Management or by a decree of a Court of Law and/or that the corner points mentioned in lines 3, 4 and 5 above were in conformance with the rules of the Michigan Board of Land Surveyors or by a Decree of a Court of Law; established, re-established, monumented, re-monumented, recovered, found as expressed below:

NOTE: Not more than 4 corners, all in the same town and range, may be recorded on this certificate.

A. Description of original monument and accessories and/or subsequent restoration:

1. Post set in Original Government Survey by Hervey Parke D.S. on February 7, 1826 with the following witnesses:  
Beech 10 S36W .11-1/2 (7.6')  
Do. 8 N25E .25-1/2 (16.8')

Continued on Back


B. Description of corner evidence found and/or method applied in restoring or reestablishing corner:

Searched area at location of corner and did not find 1/2" bolt recorded by Oscar Boss, but his witnesses fit 1" bar found. Did not find boat spike or 1/2" bar as described by Ronnie Lester and Lohr. Their witnesses fit 1" bar found. Found 1" bar as described by Maurice Mahieu and his witnesses agree with 1" bar found. Note that Rayner's witness (Item 2) is Rowe's second witness (Item 3). The apple and tamarack no longer exist (Item 3). The 1" iron bar found fits the 1 remaining witness of W.A. Rowe from 1895 (Item 3): stone (topped) N39°W, 77-1/2 (51.2'). Stone is a 6 ton boulder. Excavation around 1" bar revealed that it was pitted and very old in appearance. I believe that the 1" bar is the marker called for (and probably set) by Rowe to perpetuate the corner position and accept it as such. Set monument box on August 19, 1993.

C. Description of monument for corner and accessories established to perpetuate locating the position of the corner:

I-4 T2N R2W  
1" Solid Iron Bar in monument box.  
Found Nail and Tag #30090 (David Lohr) in East side 10" Elm, Az 317°, 55.20'  
Found Nail and Tag #28414 in South side 28" Maple, Az 96°, 37.06'  
Found Nail and Tag #18998 in East side 54" Poplar, Az 203°, 84.25'  
NE corner foundation house #256 Aurelius Road, Az 240°, 112.25'  
Crack in top of 6 ton boulder, Az 321°, 51.20' (1895 witness)  
Corner is 1.5' east of centerline of bituminous surface for Aurelius Road and 4' south of centerline of Elliot Road to west and on tree line to east.

Signed by R. Enger  
Surveyor's Michigan License No. 28409  
2544

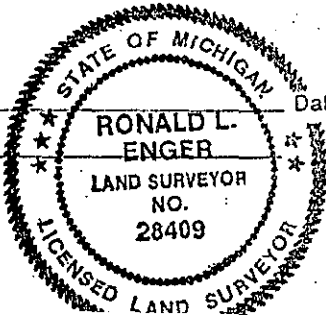

Date October 26, 1993

FORM APPROVED BY MICHIGAN STATE BOARD OF LAND SURVEYORS, JAN. 26, 1971  
REVISED MAY 14, 1975  
P.A. 345 INGHAM COUNTY  
PEER APPROVED 10/28/93

I-4 T2N R2W  
Part A continued

2. W.H. Rayner, County Surveyor, reported using corner in a survey dated November 4, 1867 and recorded in Misc. Field Notes, Page 30 with one witness:  
Apple 4 S83E 75 (49.5')
3. W.A. Rowe, County Surveyor, in survey No. 1831 dated May 1, 2, 3, and 4, 1895 and recorded in Volume 3, Page 232, County Surveyors Records labels corner as "B" and notes "point B was found from old witnesses made while the original marks could be found" describes marker as an Iron Shaft with the following witnesses:  
Tamarac 6 S24-1/2W 166 (109.6)  
Apple 12 S83E 75 (49.5)  
Stone (?opped) N39W 77-1/2 (51.2')  
Rowe shows 40.05 chains to north and to south.
4. Oscar Boss LS #13574 recorded corner on April 25, 1974, in Liber 3 of Corners, Page 95, as a found 1/2" Bolt with the following witnesses:  
Set Nail in SW side 8" tree N43°W 55.22'  
Set Nail in North side 24" Maple S88°E 36.3'  
Set Nail in West side 54" tree S35°W 84.65'
5. Oscar Boss LS #13574 reported using corner on December 6, 1973 and February 27, 1975, and recorded in Liber 1 of Surveys, Page 1090 and Liber 2 of Surveys, Page 349, Ingham County Records as a found 1/2" Bolt with the same witnesses as found on his LCRC (Item 4).
6. George Young LS #17640 reported using corner on August 7, 1974, recorded in Liber 2 of Surveys, Page 117, Ingham County Records, does not describe the corner marker and shows the same witnesses as on Oscar Boss' LCRC (Item 4).
7. George Young LS #17640 reported using corner on November 5, 1981, in Liber 4 of Surveys, Pages 548, Ingham County Records, describes corner markers to be found 1/2" Bolt and shows the same witnesses as on Oscar Boss' LCRC (Item 4).
8. Ron Helsel LS #18994 reported using corner on December 22, 1979 and recorded in Liber 4 of Surveys, Page 70 of Ingham County Records references "Liber 3, Page 95" and does not mention monument or witnesses.
9. Maurice H. Mahieu LS #28414 reported using corner on August 13, 1991 and recorded in Liber 6 of Surveys, Page 808 of Ingham County Records as a 1" Iron Rod with the following witnesses:  
Nail and Tag #28414 North side 24" Maple, S75°E, 45.95'  
Nail and Tag #28414 South side 36" Maple, East, 37.02'  
Nail and Tag #18998 East side 54" Poplar, S20°W, 84.28'  
Nail and Tag #28414 West side wood fence post, S30°E, 74.93'
10. Ronnie M. Lester LS #18998 reported using corner in November 1991 and recorded in Liber 6 of Surveys, Page 867 of Ingham County Records as a found boatspike, set 1/2" bar with the following witnesses:  
Nail and Tag in North side 36" Maple, 96° Az, 36.3'  
Nail and Tag in East side 48" Cottonwood, 203° Az, 84.2'  
Nail and Tag in NE side utility pole, 308° Az, 48.6'  
NE cor. house #256 foundation 238° Az, 112.3'
11. Unrecorded survey by David R. Lohr dated April 1, 1993 identifies corner marker as "Fd. 1/2" bar as per Liber 3 Pg. 95" and shows four witnesses:  
Set N & T, 12" Elm, N38°W, 55.25'  
Fd. N & T, 24" Maple, S88°E, 37.05'  
Fd. N & T, 54" Oak, S21°W, 84.25'  
Fd. N & T, 15" Maple, S69°E, 45.95'