

SURVEY & REMONUMENTATION

APR 10 1995

LAND CORNER RECORDATION CERTIFICATE

Meeting Requirement of Act 74, Mich. P.A. 1970

LIBER 8 PAGE 288

FILED

For corners in

INGHAM

(County)

AURELIUS TOWNSHIP

Located In:

Corner Code ##

- | | | |
|---------------------------------------|-------------------------|------------|
| 1. Public Land Survey | T <u>2N</u> R <u>2W</u> | <u>J-2</u> |
| | T _____ R _____ | _____ |
| | T _____ R _____ | _____ |
| | T _____ R _____ | _____ |
| 2. Property Controlling in Section | S _____ T _____ R _____ | _____ |
| | S _____ T _____ R _____ | _____ |
| 3. Miscellaneous Property in Sec. | S _____ T _____ R _____ | _____ |
| | S _____ T _____ R _____ | _____ |
| 4. Lot No. _____, Recorded-Plat _____ | | |
| 5. Private Claims _____ | | |

Nov 8 11 19 AM '94

REGISTER OF DEEDS
Ronald L. Enger
 INGHAM COUNTY, MICH.

Register of Deeds Stamp & File Number

	A	B	C	D	E	F	G	H	I	J	K	L
2	6		5		4		3			●		1
3												
4	7		8		9		10			11		12
5												
6	18		17		16		15			14		13
7												
8	19		20		21		22			23		24
9												
10	30		29		28		27			26		25
11												
12	31		32		33		34			35		36
13												

I, RONALD L. ENGER, in a field survey on AUGUST 30, 19 93

do hereby certify that under requirements of P.A. 74, Michigan P.A. of 1970, the corner points mentioned in lines 1 and 2 above were in conformance with regulations and rules therefore as required in the current manual of survey instructions of the United States Department of the Interior, Bureau of Land Management or by a decree of a Court of Law and/or that the corner points mentioned in lines 3, 4 and 5 above were in conformance with the rules of the Michigan Board of Land Surveyors or by a Decree of a Court of Law; established, re-established, monumented, re-monumented, recovered, found as expressed below:

NOTE: Not more than 4 corners, all in the same town and range, may be recorded on this certificate.


A. Description of original monument and accessories and/or subsequent restoration:

1. POST NOT SET IN ORIGINAL GOVERNMENT SURVEY.
2. ANSON JACKSON, COUNTY SURVEYOR REPORTED USING CORNER IN VARIOUS SURVEYS DATED 1838, 1845 AND 1846 AND RECORDED IN MISC. FIELD NOTES PG 28 COUNTY SURVEYORS RECORDS WITH NO MENTION OF MONUMENT AND THE FOLLOWING WITNESSESS LYNN 10" N52W 18(11.9'), LYNN 8" S28W 17(11.2') ANSON JACKSON COUNTY SURVEYOR AGAIN REPORTED USING CORNER IN A SURVEY DATED DEC. 19 1854 AND RECORDED IN VOL. 2, PG 229 WITH NO MENTION OF MONUMENT AND WITNESSED BY: B. ASH 9 N22W 25 1/2, ELM 9 S35W 33

CONTINUED ON BACK

B. Description of corner evidence found and/or method applied in restoring or reestablishing corner:

SEARCHED AT LOCATION OF CORNER AND FOUND 1/2" BAR WITH CAP #25832 ON EAST SIDE 4 WAY ANCHOR POST WITH L. BRYAN WITNESSESS FROM HIS LCRC AND MAURICE MAHIEU WITNESS TAGS IN VARIOUS TREES AROUND CORNER. ANCHOR POST IS AT INTERSECTION OF 1/4 LINES. ACCEPTED ANCHOR POST AS LOCATION OF CORNER AS DESCRIBED BY A. JACKSON IN THE 1830'S, 1840'S AND 1850'S. REPLACED 1/2" BAR WITH STANDARD BAR AND CAP AND USED AS THE CORNER MONUMENT. MEASURED WEST 2663.14 FEET TO 1-2, MEASURED SOUTH 2654.64 TO J-3, MEASURED EAST 2656.12 TO K-2. MEASURED NORTH 2603.66 TO J-1.

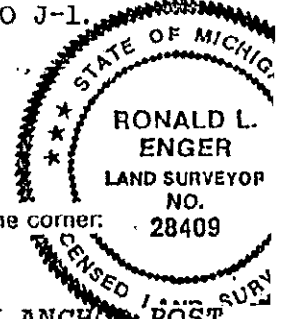

C. Description of monument for corner and accessories established to perpetuate locating the position of the corner:

- J-2 T2N R2W
- 3/4" SMOOTH STEEL BAR AND PA 345 CAP #28409 ON EAST SIDE OF FOUR-WAY ANCHOR POST
 - FOUND NAIL AND TAG #28414 IN EAST SIDE 6" ELM, AZ. 180°, 5.86'
 - FOUND NAIL AND TAG #28414 IN EAST SIDE 36" LINDEN AZ. 355°, 27.23'
 - SET NAIL AND TAG #28409 IN NORTHEAST SIDE 36" MAPLE AZ. 320°, 13.88'
 - FOUND NAIL AND TAG #28414 IN NORTH SIDE 18" MAPLE, AZ. 280°, 18.05'

Signed by

Ronald L. Enger

Date OCTOBER 10, 1994

Surveyor's Michigan License No. 28409

P.A. 345 INGHAM COUNTY

J-2 T2N R2W
PART A CONTINUED

2. LARRY BRYAN, LS #25832 RECORDED CORNER ON APRIL 20, 1987 IN LIBER 6 OF CORNERS PAGE 323 AS A SET 1/2" BAR AND CAP WITH THE FOLLOWING WITNESSES:

- 1. SET NAIL AND TAG IN NE SIDE 36" MAPLE, N45°W, 13.51'
- 2. SET NAIL AND TAG IN NORTH SIDE 6" ELM, EAST 18.00'
- 3. SET NAIL AND TAG IN EAST SIDE 6" ELM, SOUTH 5.98'

3. MAURICE H. MAHIEU, LS #28414, USED CORNER IN JUNE 1993 AND WITNESSED IT.

[The following text is extremely faint and largely illegible, appearing to be a continuation of a survey or legal document. It contains several lines of text, possibly including names and dates, but the characters are too light to transcribe accurately.]

