

**SURVEY & REMONUMENTATION**

APR 10 1995

**COMMISSION**

**LAND CORNER RECORDATION CERTIFICATE**  
Filing Requirement of Act 74, Mich. P.A. 1970

LIBER 8 PAGE 290

For corners in

INGHAM

(County)

AURELIUS TOWNSHIP

Located in:

Corner Code J-3

- |                                       |     |     |            |
|---------------------------------------|-----|-----|------------|
| 1. Public Land Survey                 | T2N | R2W | <u>J-3</u> |
|                                       | T   | R   |            |
|                                       | T   | R   |            |
|                                       | T   | R   |            |
| 2. Property Controlling in Section    | S   | T   | R          |
|                                       | S   | T   | R          |
| 3. Miscellaneous Property in Sec.     | S   | T   | R          |
|                                       | S   | T   | R          |
| 4. Lot No. _____, Recorded Plat _____ |     |     |            |
| 5. Private Claims _____               |     |     |            |

**FILED**

Nov 8 11 19 AM '94

REGISTER OF DEEDS

*Paul Johnson*

INGHAM COUNTY, MICHIGAN

Register of Deeds Stamp & File Number

I, RONALD L. ENGER, in a field survey on AUGUST 20, 1993, 19\_\_\_\_\_, do hereby certify that under requirements of P.A. 74, Michigan P.A. of 1970, the corner points mentioned in lines 1 and 2 above were in conformance with regulations and rules therefore as required in the current manual of survey instructions of the United States Department of the Interior, Bureau of Land Management or by a decree of a Court of Law and/or that the corner points mentioned in lines 3, 4 and 5 above were in conformance with the rules of the Michigan Board of Land Surveyors or by a Decree of a Court of Law; established, re-established, monumented, re-monumented, recovered, found as expressed below:

**NOTE: Not more than 4 corners, all in the same town and range, may be recorded on this certificate.**

	A	B	C	D	E	F	G	H	I	J	K	L
2	6		5		4		3		2		1	
3										•		
4	7		8		9		10		11		12	
5												
6	18		17		16		15		14		13	
7												
8	19		20		21		22		23		24	
9												
10	30		29		28		27		26		25	
11												
12	31		32		33		34		35		36	
13												

A. Description of original monument and accessories and/or subsequent restoration:

1. ORIGINAL POST SET BY HERVEY PARKE D.S. ON FEBRUARY 7, 1826  
BEECH 14 N38W 11 (7.3')  
SUGAR 24 S30E 27 (17.8')
2. ANSON JACKSON, COUNTY SURVEYOR, USED CORNER IN A SURVEY ON FEBRUARY 7, 1845 RECORDED IN VOL 1, PAGE 13 WITH SAME MONUMENT AND WITNESSES AS IN ITEM 1.


CONTINUED ON BACK

B. Description of corner evidence found and/or method applied in restoring or reestablishing corner:

SEARCHED AT APPARENT LOCATION OF CORNER AND FOUND BOAT SPIKE IN MONUMENT BOX ON CENTERLINE COLUMBIA ROAD AND ON OLD FENCELINE TO NORTH. EXCAVATED THROUGH BOTTOM OF MONUMENT BOX TO A DEPTH OF 3' AND FOUND ONLY CLEAN YELLOW SAND. AS SURROUNDING SOIL IS DIRTY GRAY CLAY, ASSUMED THAT SAND WAS PLACED DURING ROAD CONSTRUCTION. ONE SIDE OF ROAD IS IN SLIGHT CUT SECTION AND OTHER SIDE IS FILL SECTION. BELIEVE THAT ANY EVIDENCE OF HISTORICAL CORNER WAS DESTROYED DURING CONSTRUCTION AND SO ACCEPTED BOAT SPIKE AS BEST AVAILABLE EVIDENCE OF PERPETUATION OF CORNER AND SET STANDARD MARKER FOR PA 345 REMONUMENTATION IN INGHAM COUNTY IN ITS PLACE. MEASURED 2658.38' WEST TO I-3, 2662.58' EAST TO K-3 AND 2654.64' NORTH TO J-2.

C. Description of monument for corner and accessories established to perpetuate locating the position of the corner:

J-3 T2N R2W  
3/4" DIAMETER BY 24" LONG SMOOTH STEEL BAR AND CAP IMPRINTED "PA 345 PS 28409" IN MONUMENT BOX.  
FOUND NAIL AND TAG #18998 IN EAST SIDE UTILITY POLE, 0° AZ., 60.90'  
FOUND 1/2" BAR AND CAP #28414 (M. MAHIEU), 359° AZ., 33.00'  
FOUND 1/2" BAR AND CAP #18998, 245° AZ., 105.55'  
FOUND NAIL AND TAG #18998 IN NORTH SIDE UTILITY POLE, 264° AZ., 203.77'  
SE CORNER HOUSE FOUNDATION, 341° AZ., 179.05'  
CORNER IS ON CENTERLINE COLUMBIA RD.

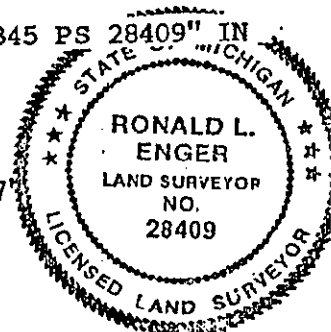

Signed by *R. Enger*

Date OCTOBER 10, 1994

Surveyor's Michigan License No. 28409

P.A. 345 INGHAM COUNTY

J-3 T2N R2W  
PART A CONTINUED

3. RONNIE M. LESTER, LS #18998, RECORDED CORNER IN LIBER 3 OF CORNERS, PAGE 165 IN JULY, 1974, AS A FOUND BOATSPIKE AND USED IN A SURVEY IN JULY, 1974, RECORDED IN LIBER 2 OF SURVEYS, PG 14.

STEEL FENCE POST, NNE, 34.03'

$\frac{1}{2}$ " BAR, SSE, 33.72'

$\frac{1}{2}$ " BAR, NE, 66.89'

4. R. LESTER USED CORNER AGAIN IN SURVEYS IN NOVEMBER, 1991, RECORDED IN LIBER 6 OF SURVEYS, PAGES 851-858, AS A FOUND BOATSPIKE IN MONUMENT BOX.

CENTERLINE PHONE CABLE BOX, AZ. 178°, 26.7'

SET NAIL AND TAG IN EAST SIDE UTIL. POLE, AZ. 05°, 60.8'

SET NAIL AND TAG IN WEST SIDE OF 12" ELM, AZ. 04°, 88.7'

SET NAIL AND TAG IN NORTH SIDE UTIL. POLE, AZ. 268°, 203.7'