

SURVEY & REMONUMENTATION LAND CORNER RECORDATION CERTIFICATE
 Filing Requirement of Act 74, Mich. P.A. 1970

LIBER 8 PAGE 292

For corners in
INGHAM

APR 10 1995

FILED

AURELIUS TOWNSHIP COMMISSION

Located In: _____ Corner Code # _____

- | | | | | | |
|------------------------------------|---|-----------|---|-----------|------------|
| 1. Public Land Survey | T | <u>2N</u> | R | <u>2W</u> | <u>J-4</u> |
| | T | _____ | R | _____ | _____ |
| | T | _____ | R | _____ | _____ |
| | T | _____ | R | _____ | _____ |
| 2. Property Controlling in Section | S | _____ | T | _____ | _____ |
| | S | _____ | T | _____ | _____ |
| 3. Miscellaneous Property in Sec. | S | _____ | T | _____ | _____ |
| | S | _____ | T | _____ | _____ |
4. Lot No. _____, Recorded Plat _____
5. Private Claims _____

NOV 8 11 19 AM '94

REGISTER OF DEEDS
Paul Johnson
INGHAM COUNTY, MICH.

Register of Deeds Stamp & File Number

A	B	C	D	E	F	G	H	I	J	K	L
2	6	5	4	3	2	1					
3											
4	7	8	9	10	11	12					
5											
6	18	17	16	15	14	13					
7											
8	10	20	21	22	23	24					
9											
10	30	29	28	27	26	25					
11											
12	31	32	33	34	35	36					
13											

I, RONALD L. ENGER, in a field survey on AUGUST 30, 1993,

do hereby certify that under requirements of P.A. 74, Michigan P.A. of 1970, the corner points mentioned in lines 1 and 2 above were in conformance with regulations and rules therefore as required in the current manual of survey instructions of the United States Department of the Interior, Bureau of Land Management or by a decree of a Court of Law and/or that the corner points mentioned in lines 3, 4 and 5 above were in conformance with the rules of the Michigan Board of Land Surveyors or by a Decree of a Court of Law; established, re-established, monumented, re-monumented, recovered, found as expressed below:

NOTE: Not more than 4 corners, all in the same town and range, may be recorded on this certificate.


A. Description of original monument and accessories and/or subsequent restoration:

- POST NOT SET IN ORIGINAL GOVERNMENT SURVEYS
- W.H. RAYNER, COUNTY SURVEYOR REPORTED USING CORNER IN A SURVEY DATED NOV. 4, 1867, AND RECORDED IN MISC. FIELD NOTES, PAGE 30, COUNTY SURVEYORS RECORDS, WITH NO MENTION OF MONUMENT OR WITNESSES.

CONTINUED ON BACK

B. Description of corner evidence found and/or method applied in restoring or reestablishing corner:

SEARCHED AT APPARENT LOCATION OF CORNER AND FOUND 1/2" BAR AND CAP #13574 AT 2 WAY FENCE CORNER IN ROOTS OF 24" BEECH TREE AND CHECKED R. LESTER'S WITNESSES. ACCEPTED 1/2" BAR AND CAP IN FENCE CORNER AS CORNER AS ESTABLISHED BY W.H. RAYNER AND USED BY SUBSEQUENT SURVEYORS. SET STANDARD 3/4"X24" INGHAM COUNTY REMONUMENTATION BAR AND CAP ALONGSIDE 1/2" BAR AND CAP AS THE 1/2" BAR IS ALMOST OVERGROWN BY THE 24" BEECH TREE.

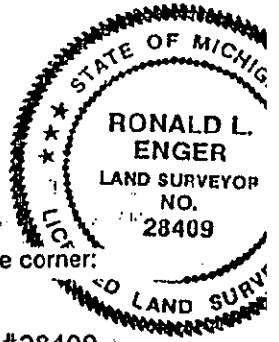

C. Description of monument for corner and accessories established to perpetuate locating the position of the corner:

J-4 T2N R2W
 STANDARD 3/4"X24" INGHAM COUNTY REMONUMENTATION BAR AND PA 345 CAP #28409 ALONGSIDE A 1/2" BAR AND CAP #13574 IN WESTERLY ROOTS OF 24" BEECH TREE AT TWO-WAY FENCE CORNER.
 FOUND NAIL AND TAG #18998 IN WEST SIDE OF 24" BEECH, AZ 358°, 0.85'
 FOUND NAIL AND TAG #18998 IN NORTH SIDE 18" TRIPLE BASSWOOD, AZ 248°, 8.6'
 SET NAIL AND TAG #28409 IN EAST SIDE OF 18" QUAD PIGNUT HICKORY, AZ. 180°, 44.85'
 SET NAIL AND TAG #28409 IN SOUTH SIDE OF 10" WILD CHERRY, AZ. 250°, 41.43'

Signed by *R. Enger* Date OCTOBER 10, 1994
 Surveyor's Michigan License No. 28409

J-4 T2N R2W
PART A CONTINUED

3. OSCAR BOSS, LS #13574, RECORDED CORNER ON APRIL 25, 1974, IN LIBER 3 OF CORNERS, PAGE 95, AS A SET 1/2" BAR AND CAP WITH THE FOLLOWING WITNESSES:
NAIL IN EAST SIDE OF 8" TREE, S5°W, 44.83'
NAIL IN EAST SIDE OF 4" TREE, S45°W, 7.1'
NAIL IN NORTH SIDE OF 4" TREE, S80°W, 7.18'
4. OSCAR BOSS, LS #13574, REPORTED USING CORNER IN A SURVEY ON DECEMBER 6, 1973, AND RECORDED IN LIBER 1 OF SURVEYS, PAGE 1090, INGHAM COUNTY RECORDS AS A SET 1/2" BAR AND CAP WITH THE SAME WITNESSES AS ON HIS LCRC.
5. R. LESTER, LS #18998, REPORTED USING CORNER IN 1989 AND 1991 AND RECORDED IN LIBER 5 AND 6 OF SURVEYS ON MANY PAGES OF INGHAM COUNTY RECORDS AS A 1/2" BAR AND CAP WITH THE FOLLOWING WITNESSES:
NAIL AND TAG IN NORTH SIDE OF 10" COTTONWOOD, 250° AZ., 8.6'
NAIL AND TAG IN NORTH SIDE OF 15" ASH, 296° AZ., 168.2'
NAIL AND TAG IN NORTH SIDE OF 24" BEECH, 358° AZ., 1.0'
NAIL AND TAG IN EAST SIDE OF PIGNUT, 180° AZ., 44.7'