

SURVEY & REMONUMENTATION

APR 10 1995

LAND CORNER RECORDATION CERTIFICATE

LIBER 8 PAGE 294

For corners in

COMMISSION

Filing Requirement of Act 74, Mich. P.A. 1970

FILED

Nov 8 11 19 AM '94

REGISTER OF DEEDS
Paula Johnson
 INGHAM COUNTY, MICH.

Register of Deeds Stamp & File Number

INGHAM <small>(County)</small>		Located In:	Corner Code ##
AURELIUS TOWNSHIP			
1. Public Land Survey	T <u>2N</u> R <u>2W</u>	<u>J-5</u>	
	T _____ R _____	_____	_____
	T _____ R _____	_____	_____
	T _____ R _____	_____	_____
2. Property Controlling in Section	S _____ T _____ R _____	_____	_____
	S _____ T _____ R _____	_____	_____
3. Miscellaneous Property In Sec.	S _____ T _____ R _____	_____	_____
	S _____ T _____ R _____	_____	_____

4. Lot No. _____, Recorded Plat _____
 5. Private Claims _____

I, RONALD L. ENGER, in a field survey on AUGUST 9, 19 94, do hereby certify that under requirements of P.A. 74, Michigan P.A. of 1970, the corner points mentioned in lines 1 and 2 above were in conformance with regulations and rules therefore as required in the current manual of survey instructions of the United States Department of the Interior, Bureau of Land Management or by a decree of a Court of Law and/or that the corner points mentioned in lines 3, 4 and 5 above were in conformance with the rules of the Michigan Board of Land Surveyors or by a Decree of a Court of Law; established, re-established, monumented, re-monumented, recovered, found as expressed below:

A	B	C	D	E	F	G	H	I	J	K	L
2	6	5	4	3	2	1					
3											
4	7	8	9	10	11	12					
5											
6	18	17	16	15	14	13					
7											
8	19	20	21	22	23	24					
9											
10	30	29	28	27	26	25					
11											
12	31	32	33	34	35	36					
13											

NOTE: Not more than 4 corners, all in the same town and range, may be recorded on this certificate.

A. Description of original monument and accessories and/or subsequent restoration:

- POST SET IN ORIGINAL GOVERNMENT SURVEY BY HERVEY PARKE D.S. ON FEBRUARY 7, 1826, WITH THE FOLLOWING WITNESSES:
 B. ASH .12 S87-1/2W .11 (7.3')
 DO. 8. S72E .03-1/2 (2.3')
- A MARGINAL NOTE ON THE INGHAM COUNTY REGISTER OF DEEDS COPY OF THE GLO NOTES STATES: NEW POST -- SANDSTONE AND 4 SMALL STONES


CONTINUED ON BACK

B. Description of corner evidence found and/or method applied in restoring or reestablishing corner:

SEARCHED AT APPARENT LOCATION OF CORNER AND FOUND 1/2" BAR AND CAP #13574 AS DESCRIBED IN A-6, A-7, A-8, A-9, A-10, AND A-11. FOUND 1" SQUARE BAR AS DESCRIBED IN A-5. EXCAVATED 5'X 5' HOLE TO DEPTH OF 3.5' AROUND BOTH FOUND IRONS BUT ONLY FOUND CROCKERY AT SURFACE AROUND 1" SQUARE BAR. PROBED 6" GRID 3' OUTSIDE OF 5'X 5' HOLE IN AN ATTEMPT TO FIND SANDSTONE POST MENTIONED IN A-2. DID NOT FIND ANY OTHER EVIDENCE OF CORNER; OF ICRC WITNESSES FOUND TO 1" SQUARE BAR ONLY ONE MAKES ANY SENSE. ACCEPTED 1/2" BAR AND CAP AS CORNER ONLY BECAUSE UNABLE TO PROVE THE AUTHENTICITY OF SQUARE BAR. REPLACED 1/2" BAR AND CAP WITH STANDARD INGHAM COUNTY SMOOTH BAR AND CAP. MEASURED EAST 2662.67' TO K-5. MEASURED WEST 2664.86 FEET TO I-5.

C. Description of monument for corner and accessories established to perpetuate locating the position of the corner:

J-5 T2N R2W
 3/4"X 24" STANDARD SMOOTH STEEL BAR AND PA 345 CAP PS # 28409
 FOUND NAIL AND TAG #28414 IN SOUTH SIDE 15" OAK, AZ 284°, 58.31'
 FOUND NAIL AND TAG #18998 IN NORTH SIDE 10" OAK, AZ 254°, 15.75'
 FOUND NAIL AND TAG #18998 IN EAST SIDE 40" OAK, AZ 332°, 21.83'
 FOUND NAIL AND TAG #18998 IN SE SIDE 36" OAK, AZ 41°, 33.26'
 1" SQUARE BAR, AZ 236°, 5.29'

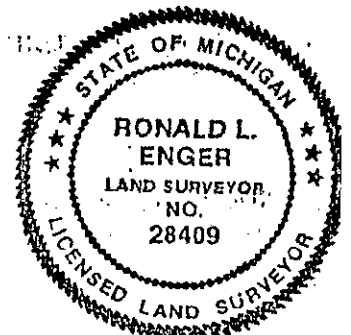

Signed by *R. Enger* Date OCTOBER 10, 1994

Surveyor's Michigan License No. 28409

INGHAM COUNTY

J-5 T2N R2W
PART A CONTINUED

3. W.H. RAYNER, COUNTY SURVEYOR REPORTED USING CORNER IN A SURVEY DATED NOVEMBER 4, 1867 AND RECORDED IN MISC. FIELD NOTES PAGE 30, COUNTY SURVEYORS' RECORDS WITH NO MENTION OF MONUMENT AND THE FOLLOWING WITNESS:
WILLOW 6' N33E 7'
4. R.J. ROBB COUNTY SURVEYOR REPORTED USING CORNER IN A SURVEY OF NORTH BRANCH OF WILLOW CREEK DRAIN DATED APRIL 1906 WITH NO MENTION OF MONUMENT OR WITNESSES.
5. INGHAM COUNTY ROAD COMMISSION WITNESSES, DATED PRIOR TO 1960, CALL FOR A 1" IRON BAR AND CROCKERY WITH THE FOLLOWING WITNESSES:
13" OAK, NE 38.5'
8" OAK N 30.9'
8" OAK NNW 33.1'
6. OSCAR BOSS, LS #13574, RECORDED CORNER ON APRIL 25, 1974, IN LIBER 3 OF CORNERS, PAGE 95, AS A "SET 1/2" IRON, SPLIT MILE FROM SW CORNER, SEC. 11 TO SE COR. SEC. 11", WITH THE FOLLOWING WITNESSES:
SET NAIL WEST SIDE 36" OAK, N5°E, 33.25'
SET NAIL SOUTH SIDE 36" TREE, N50°E, 33.15'
SET NAIL EAST SIDE 40" OAK, N25°W, 22.00'
7. OSCAR BOSS LS #13574 REPORTED USING CORNER ON DECEMBER 6, 1973, AND RECORDED IN LIBER 1 OF SURVEYS, PAGE 1090 INGHAM COUNTY RECORDS AS A 1/2" IRON SET WITH WITNESSES THE SAME AS ON LCRC AND SHOWS A DISTANCE OF 2662.62' TO FOUND 1/2" BOLT AT I5; 2662.62' TO FOUND NAIL AT K5 AND 2642.60' TO 1/2" IRON SET AT J4.
8. OSCAR BOSS REPORTED USING CORNER AGAIN ON FEBRUARY 27, 1975, AND RECORDED IN LIBER 2 OF SURVEYS, PAGE 349, AS A 1/2" IRON WITH WITNESSES THE SAME AS LCRC.
9. RONNIE M. LESTER LS #18998 REPORTED USING CORNER IN APRIL 1989, IN SURVEYS RECORDED IN LIBER 5 OF SURVEYS, PAGES 1034, 1037, 1039 AND 1062 AS A 1/2" BAR AND CAP WITH THE FOLLOWING WITNESSES:
SET NAIL AND TAG IN SE SIDE 36" OAK, 40° AZ, 33.2'
SET NAIL AND TAG IN EAST SIDE 36" OAK, 330° AZ, 21.9'
SET NAIL AND TAG IN NORTH SIDE 12" OAK, 260° AZ, 15.9'
FOUND NAIL AND TAG #25832 IN WEST SIDE 36" MAPLE, 10° AZ, 33.2'
AND SHOWS A DISTANCE OF 2664.81' TO FOUND BAR AND CAP AT I5; 2662.23' TO FOUND SPIKE AT K5
AND 2642.48' TO FOUND 1/2" BAR AND CAP AT J4.
10. MAURICE H. MAHIEU LS #28414 REPORTED USING CORNER ON OCTOBER 4, 1991, AND RECORDED IN LIBER 6 OF SURVEYS, PAGE 808, OF INGHAM COUNTY RECORDS AS A FOUND 1/2" ROD WITH CAP #13574 WITH THE FOLLOWING WITNESSES:
NAIL AND TAG #18998 IN NORTH SIDE 12" OAK, S85°W, 15.80'
NAIL AND TAG #18998 IN NE SIDE 42" OAK, N20°W, 21.95'
NAIL AND TAG #28414 IN SOUTH SIDE (4) 8" OAK, N75°W, 36.15'
NAIL AND TAG #28414 IN SOUTH SIDE 24" OAK, WEST 58.45'
AND SHOWS A DISTANCE OF 2664.91' TO 1/2" IRON ROD WITH CAP AT I5
11. CERTIFIED SURVEY BY R. LESTER RECORDED IN LIBER 6 OF SURVEYS, PAGE 865 ON NOVEMBER 25, 1991 IDENTIFIES CORNER AS 1/2" BAR AND CAP #13574 AND SHOWS WITNESSES USED FOR HIS 1989 CERTIFICATES (ITEM 8 ABOVE).