

**SURVEY & REMONUMENTATION**

APR 10 1995

**LAND CORNER RECORDATION CERTIFICATE**

LIBER 8 PAGE 296

For corners in

**COMMISSION**

Filing Requirement of Act 74, Mich. P.A. 1970

FILED

INGHAM

Located In:

Corner Code ≠#

(County)

AURELIUS TOWNSHIP

- |                                    |                         |            |
|------------------------------------|-------------------------|------------|
| 1. Public Land Survey              | T <u>2N</u> R <u>2W</u> | <u>K-1</u> |
|                                    | T _____ R _____         | _____      |
|                                    | T _____ R _____         | _____      |
|                                    | T _____ R _____         | _____      |
| 2. Property Controlling in Section | S _____ T _____ R _____ | _____      |
|                                    | S _____ T _____ R _____ | _____      |
| 3. Miscellaneous Property in Sec.  | S _____ T _____ R _____ | _____      |
|                                    | S _____ T _____ R _____ | _____      |

Nov 8 11 19 AM '94

REGISTER OF DEEDS

*Daniel J. Johnson*  
INGHAM COUNTY, MICH.

Register of Deeds Stamp & File Number

4. Lot No. \_\_\_\_\_, Recorded Plat \_\_\_\_\_
5. Private Claims \_\_\_\_\_

A	B	C	D	E	F	G	H	I	J	K	L
2	6	5	4	3	2						
3											
4	7	8	9	10	11	12					
5											
6	16	17	16	15	14	13					
7											
8	19	20	21	22	23	24					
9											
10	30	29	28	27	26	25					
11											
12	31	32	33	34	35	36					
13											

I, RONALD L. ENGER, in a field survey on OCTOBER 26, 1993


do hereby certify that under requirements of P.A. 74, Michigan P.A. of 1970, the corner points mentioned in lines 1 and 2 above were in conformance with regulations and rules therefore as required in the current manual of survey instructions of the United States Department of the Interior, Bureau of Land Management or by a decree of a Court of Law and/or that the corner points mentioned in lines 3, 4 and 5 above were in conformance with the rules of the Michigan Board of Land Surveyors or by a Decree of a Court of Law; established, re-established, monumented, re-monumented, recovered, found as expressed below:

NOTE: Not more than 4 corners, all in the same town and range, may be recorded on this certificate.

A. Description of original monument and accessories and/or subsequent restoration:

1. POST SET IN ORIGINAL GOVERNMENT SURVEY BY HERVEY PARKE, D.S. ON FEB. 6, 1826. "INTERSECTED TOWN LINE 23 LKS (15.2') W. OF POST" AND SHOWS 2 WITNESSES:  
BEECH 24 S86½E 37 LKS (24.4')  
DO 8 S42½W 43 LKS (28.4').

CONTINUED ON BACK

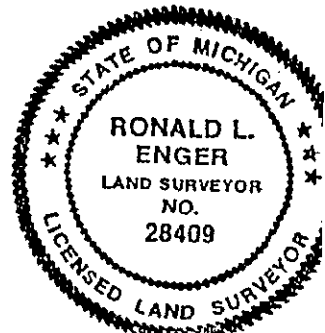

B. Description of corner evidence found and/or method applied in restoring or reestablishing corner:

SEARCHED AT APPARENT LOCATION OF CORNER AND FOUND 4" DIAMETER CONCRETE MONUMENT WITH CAP #18998 IN MONUMENT BOX. PROVED CONCRETE MONUMENT TO BE IN POSITION RECORDED BY LESTER (PART A ITEM 5) BY 2 OF HIS WITNESSES: 27" BASSWOOD (MISTAKENLY DESCRIBED AS AN ELM) IN THE SE QUAD. AND THE PORCH FOUNDATION IN THE NW QUAD. NOTE THAT THE MEASURED FALLING DISTANCE TO THE 1/2" BAR RECORDED IN LIBER 2 CORNERS PAGE 161 FOR K-13, T3N R2W, IS 11.9 FEET SHORTER THAN THE GLO. DISTANCE. TRAVERSED ALL OF SECTION 2, T2N, R2W, AND PARTS OF SECTION 35, T3N, R2W, AND CONFIRMED THAT CONCRETE MONUMENT IS AT THE NE CORNER OF SECTION 2 AS IT IS RECORDED TO BE. ACCEPTED CONCRETE MONUMENT AS MARKER AT POSITION OF CORNER K-1. MEASURED WEST 2654.45' TO J-1 AND SOUTH 2580.96' TO K-2.

C. Description of monument for corner and accessories established to perpetuate locating the position of the corner:

K-1 T2N R2W  
4 INCH DIAMETER CONCRETE MONUMENT WITH 1/2 INCH REBAR AND CAP #18998 IN MONUMENT BOX  
SET 20D GALV. SPIKE AND TAG PS 28409 IN WEST SIDE OF 27" BASSWOOD, 163° AZ., 77.02'  
SET 20D GALV. SPIKE AND TAG PS 28409 IN SOUTH SIDE OF 40" OAK, 60° AZ., 105.50'  
SET 20D GALV. SPIKE AND TAG PS 28409 IN EAST SIDE OF 23" MAPLE, 333° AZ., 53.54'  
SET 20D GALV. SPIKE AND TAG PS 28409 IN NORTH SIDE OF FENCE POST, 270° AZ., 33.30'  
SE CORNER PORCH FOUNDATION, 322° AZ., 87.42'  
1/2" BAR IN MONUMENT BOX, 100° AZ., 3.31'  
CORNER IS 3.5' WEST OF CENTERLINE EDGAR RD. AND 3.5' SOUTH OF CENTERLINE HOWELL RD.

Signed by R. Enger Date SEPTEMBER 14, 1994

Surveyor's Michigan License No. 28409  
P A 345 INGHAM COUNTY

K-1 T2N R2W  
PART A CONTINUED

2. ANSON JACKSON, CO. SURVEYOR, USED CORNER IN A SURVEY ON MAY 4, 1846, RECORDED IN VOL. 1, PAGE 106, CO. SURVEYOR RECORDS WITH SAME MARKER AND WITNESSES AS GLO (ITEM 1 ABOVE).
3. A.P. DRAKE CO. SURVEYOR USED CORNER IN A SURVEY ON APRIL 1, 1880, RECORDED IN VOL. 3 PAGE 169 CO. SURVEYORS RECORDS AS A STONE, BRICK AND CROCKERY.
4. LAVERNE HENDRYX, LS #3276, USED CORNER IN A SURVEY IN JUNE, 1978, RECORDED IN LIBER 3 OF SURVEYS, PAGE 449, WITH NO MENTION OF MON. OR WITNESSES.
5. RONNIE M. LESTER, LS #18998, RECORDED CORNER IN AUG. 1978, IN LIBER 4 OF CORNERS, PAGE 272. INGHAM COUNTY SURVEY AND REMONUMENTATION PROJECT EXCAVATED ON APRIL 26, 1978 AND FOUND PLOWPOINT IN CIRCLE OF BRICKS ON TOP OF STONES. ALL THIS WAS REPLACED WITH A 4"X 36" CONCRETE MONUMENT WITH 1/2" X 38" REROD WITH CAP #18998. FIVE WITNESSES ARE SHOWN:
  - NAIL AND TAG #18998 SOUTH SIDE 22" MAPLE, NE, 75.58'
  - NAIL AND TAG #18998 WEST SIDE 20" ELM, SE, 76.81'
  - NAIL AND TAG #12034 (FRED WHITE) NORTH SIDE 6" FENCE POST, NW, 33.41'
  - SE CORNER CONCRETE FOUNDATION OF PORCH, WNW, 87.47'
  - 1/2" IRON (K-13, T3N, R2W) AS RECORDED IN LIBER 2, PAGE 161, EAST 3.31'
6. G. YOUNG, LS #17640, USED CORNER IN A SURVEY IN APRIL 1979 RECORDED IN LIBER 3 OF SURVEYS PAGE 845 WITH SAME MONUMENT AND WITNESSES AS IN ITEM #5.