

SURVEY & REMONUMENTATION
DEC 16 1993
COMMISSION

LIBER 7 PAGE 387
 FILED

OCT 20 2 05 PM '93

LAND CORNER RECORDATION CERTIFICATE
 Filing Requirement of Act 74, Mich. P.A. 1970

REGISTER OF DEEDS
Francis Johnson
 INGHAM COUNTY, MICH.

For corners in

<u>INGHAM</u> (County)	Located In:	Corner Code ==
<u>AURELIUS TOWNSHIP</u>		
1. Public Land Survey	T <u>2N</u> R <u>2W</u>	<u>K=2</u>
	T _____ R _____	_____
	T _____ R _____	_____
	T _____ R _____	_____
2. Property Controlling in Section	S _____ T _____ R _____	_____
	S _____ T _____ R _____	_____
3. Miscellaneous Property in Sec.	S _____ T _____ R _____	_____
	S _____ T _____ R _____	_____
4. Lot No. _____, Recorded Plat _____		
5. Private Claims _____		

Register of Deeds Stamp & File Number

	A	B	C	D	E	F	G	H	I	J	K	L	M
2	6	5	4	3	2	1							
3													
4	7	8	9	10	11	12							
5													
6	16	17	18	15	14	13							
7													
8	19	20	21	22	23	24							
9													
10	30	29	28	27	26	25							
11													
12	31	32	33	34	35	36							
13													

I, RONALD L. ENGER in a field survey on AUGUST 11, 19 93, do hereby certify that under requirements of P.A. 74, Michigan P.A. of 1970, the corner points mentioned in lines 1 and 2 above were in conformance with regulations and rules therefore as required in the current manual of survey instructions of the United States Department of the Interior, Bureau of Land Management or by a decree of a Court of Law and/or that the corner points mentioned in lines 3, 4 and 5 above were in conformance with the rules of the Michigan Board of Land Surveyors or by a Decree of a Court of Law; established, re-established, monumented, re-monumented, recovered, found as expressed below:

NOTE: Not more than 4 corners, all in the same town and range, may be recorded on this certificate.


A. Description of original monument and accessories and/or subsequent restoration:

1. POST SET IN ORIGINAL GOVERNMENT SURVEY BY HERVEY PARKE, DEPUTY SURVEYOR, ON FEBRUARY 6, 1826 WITH THE FOLLOWING WITNESSES:
 BEECH 5 S43-1/2W 19 (12.5')
 WHITEWOOD 30 N64E 14 (9.2')

CONTINUED ON BACK

B. Description of corner evidence found and/or method applied in restoring or reestablishing corner:

SEARCHED AT APPARENT LOCATION OF CORNER AND FOUND 4" CONCRETE MONUMENT WITH 1/2" REBAR (BADLY BENT) IN MONUMENT BOX ON CENTERLINE EDGAR ROAD. PROVED MONUMENT TO BE IN POSITION PREVIOUSLY RECORDED BY USING R. LESTER'S 1978 WITNESSES. ACCEPTED CONCRETE MONUMENT AS MARKER AT CORNER POSITION. CUT BENT PORTION OF 1/2" REBAR OFF AND RAISED MONUMENT BOX TO SURFACE WITH ADJUSTING RING AND ADDED LID ON AUGUST 19, 1993.

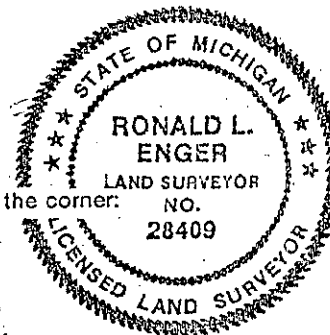

C. Description of monument for corner and accessories established to perpetuate locating the position of the corner:

K2 T2N, R2W
 FOUND 4" CONCRETE MONUMENT WITH 1/2" REBAR IN MONUMENT BOX.
 FOUND NAIL AND TAG #30090 IN SW SIDE 33" MAPLE, AZ 306°, 38.23'
 FOUND NAIL AND TAG #30090 IN WEST SIDE 18" HICKORY, AZ 25°, 64.98'
 FOUND NAIL AND TAG #30090 IN EAST SIDE 18" OAK, AZ 158°, 58.29'
 SET 20D GALV. SPIKE AND TAG #28409 IN EAST SIDE 26" MAPLE, AZ 199°, 91.48'
 SET 20D GALV. SPIKE AND TAG #28409 IN NORTH SIDE FENCE CORNER POST, AZ 90°, 19.55'

Signed by Ra Eng Date SEPTEMBER 28, 1993
 Surveyor's Michigan License No. 28409

FORM APPROVED BY MICHIGAN STATE BOARD OF LAND SURVEYORS, JAN. 28, 1971
 REVISED MAY 14, 1975
 REVISED JAN., 1983

P.A. 345 INGHAM COUNTY
 PEER APPROVED 9/14/93 u

PART A CONTINUED

2. CORNER MENTIONED IN SURVEY BY ANSON JACKSON, COUNTY SURVEYOR, IN SURVEY OF GLASGOW ROAD (NOW EDGAR ROAD) IN SURVEY DATED SEPTEMBER 4, 1846 WITH NO MENTION OF MONUMENT AND NO WITNESSES.

3. CORNER CALLED FOR AS STONE, BRICK AND TILE IN SURVEY DATED APRIL 1, 1880, BY A.P. DRAKE, COUNTY SURVEYOR, IN VOLUME 3, PAGE 169, OF INGHAM COUNTY SURVEYORS RECORDS WITH ONE WITNESS: SUGAR 5 N88W 48-3/4 LINKS (32.2)

4. CORNER RECORDED BY RONNIE M. LESTER, LS #18998, IN INGHAM COUNTY REMONUMENTATION PROJECT ON AUGUST 11, 1978, IN LIBER 4 OF CORNERS, PAGE 271, INGHAM COUNTY RECORDS. R. LESTER REPORTED EXCAVATING A 8' X 8' HOLE 3.5' DEEP. CENTERED ON EDGAR ROAD AND A FENCE LINE TO EAST AND FINDING A LARGE POINTED STONE SURROUNDED BY, AND RESTING UPON BROKEN POTTERY AND TILE, ACCEPTING STONE AS CORNER DESCRIBED BY A.P. DRAKE AND REPLACING STONE WITH 4" X 36" CONCRETE MONUMENT WITH 1/2" X 38" REROD WITH CAP #18998 IN MONUMENT BOX WITH LID WITH THE FOLLOWING WITNESSES:

NAIL AND TAG #18998 WEST SIDE WOOD CORNER POST, NNE 19.24'
NAIL AND TAG #18998 WEST SIDE 14" HICKORY, ENE, 64.99'
NAIL AND TAG #18998 SOUTH SIDE 32" OAK, NW, 38.28'
NAIL AND TAG #18998 SW SIDE 14" WHITE OAK, ESE, 58.39'

5. DAVID R. LOHR, LS #30090, REPORTED USING CORNER IN A SURVEY DATED MAY 29, 1992, RECORDED IN LIBER 6 OF SURVEYS, PAGES 968, 969, AS A 4" MONUMENT ON C/L EDGAR ROAD WITH THE SAME WITNESSES AS R. LESTER'S RECORDATION CERTIFICATE WITH D. LOHR'S TAGS.