

SURVEY &  
REMONUMENT  
DEC 1 5 1993

OCT 20 2 00 PM '93

LAND CORNER RECORDATION CERTIFICATE  
Filing Requirement of Act 74, Mich. P.A. 1970

For corner of  
INGHAM  
COMMISSION

REGISTER OF DEEDS  
Ingham County  
INGHAM COUNTY, MICH.

	Located In:	Corner Code #
AURELIUS' TOWNSHIP		
1. Public Land Survey	T <u>2N</u> R <u>2W</u>	<u>K-3</u>
	T _____ R _____	_____
	T _____ R _____	_____
	T _____ R _____	_____
2. Property Controlling in Section	S _____ T _____ R _____	_____
	S _____ T _____ R _____	_____
3. Miscellaneous Property in Sec.	S _____ T _____ R _____	_____
	S _____ T _____ R _____	_____

Register of Deeds Stamp & File Number

- 4. Lot No. \_\_\_\_\_, Recorded Plat \_\_\_\_\_
- 5. Private Claims \_\_\_\_\_

A	B	C	D	E	F	G	H	I	J	K	L	M
2	6	5	4	3	2	1						
3												
4	7	8	9	10	11	12						
5												
6	18	17	16	15	14	13						
7												
8	19	20	21	22	23	24						
9												
10	30	29	28	27	26	25						
11												
12	31	32	33	34	35	36						
13												

I, RONALD L. ENGER in a field survey on AUGUST 11, 1993, do hereby certify that under requirements of P.A. 74, Michigan P.A. of 1970, the corner points mentioned in lines 1 and 2 above were in conformance with regulations and rules therefore as required in the current manual of survey instructions of the United States Department of the Interior, Bureau of Land Management or by a decree of a Court of Law and/or that the corner points mentioned in lines 3, 4 and 5 above were in conformance with the rules of the Michigan Board of Land Surveyors or by a Decree of a Court of Law; established, re-established, monumented, re-monumented, recovered, found as expressed below:

NOTE: Not more than 4 corners, all in the same town and range, may be recorded on this certificate.


A. Description of original monument and accessories and/or subsequent restoration:

1. POST SET IN ORIGINAL GOVERNMENT SURVEY BY HERVEY PARKE, DEPUTY SURVEYOR ON FEBRUARY 6, 1826 WITH THE FOLLOWING WITNESSES:  
PEPPERAGE 24 N7W .09-1/2 (6.3')  
PEPPERAGE 8 S48E .09 (5.9')

CONTINUED ON BACK

B. Description of corner evidence found and/or method applied in restoring or reestablishing corner:

SEARCHED AREA OF CORNER AND FOUND 1/2" REBAR IN MONUMENT BOX. WITNESSES OF D. LOHR AND R. LESTER MATCH REBAR. FOUND NO TRACE OF G. YOUNG'S 1" PIPE AND ALL WITNESSES GONE. REMOVED 1/2" BAR AND EXCAVATED THROUGH BOTTOM OF MONUMENT BOX. AT 2' BELOW ROAD SURFACE FOUND 6" WOOD POST. ACCEPTED 6" WOOD POST AND 1/2" REBAR AS CORNER. SET STANDARD INGHAM COUNTY REMONUMENTATION 3/4" BAR AND PA 345 CAP #28409 IN PLACE OF REBAR IN CENTER OF WOOD POST.

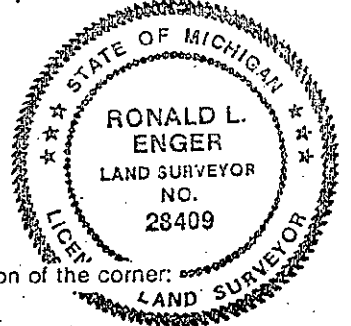

C. Description of monument for corner and accessories established to perpetuate locating the position of the corner:

K-3 T2N, R2W  
SET 3/4" X 24" SMOOTH STEEL BAR AND CAP IMPRINTED "PA345 PS 28409" IN MONUMENT BOX.  
FOUND NAIL AND TAG #18998 IN NORTH SIDE 24" MAPLE, AZ 100°, 173.23'  
FOUND NAIL AND TAG #18998 IN NORTH SIDE 30" MAPLE, AZ 265°, 294.68'  
FOUND NAIL AND TAG #18998 IN WEST SIDE POWER POLE, AZ 348°, 155.51'  
SET 20D GALV. SPIKE AND TAG #28409 IN WEST SIDE 8" OAK, AZ 186°, 309.20'  
SET 20D GALV. SPIKE AND TAG #28409 IN NORTH SIDE 24" MAPLE, AZ 94°, 385.80'

Signed by R. Enger Date OCTOBER 4, 1993  
Surveyor's Michigan License No. 28409

## PART A CONTINUED

2. CORNER MENTIONED IN A SURVEY OF GLASOW ROAD (NOW EDGAR ROAD) IN SEPTEMBER 1846 BY ANSON JACKSON, COUNTY SURVEYOR, WITH NO MENTION OF MONUMENT OR WITNESSES.
3. CORNER IS MENTIONED IN A COLLECTION OF SURVEYS BY VARIOUS COUNTY SURVEYORS ALL DRAWN ON TOP OF EACH OTHER. SURVEYORS ARE A. JACKSON AND T.J. BROWN ON FEBRUARY 21, 1845; MAY 4, 1846; AND JANUARY 11 OF UNKNOWN YEAR. SURVEY IS RECORDED IN MISC. FIELD NOTES PAGE 20.
4. CORNER SHOWN ON SURVEY IN SECTION 1 FILED IN MISC. FIELD NOTES ON PAGE 10, SHOWS WORK OF W.H. RAYNOR IN 1865 AND A. JACKSON ON MARCH 30, 1844, WITNESSES BY JACKSON FOR THIS CORNER ARE:  
BEECH 14 S45W 66  
REPUNGE 30 S25-1/2W 109
5. CORNER APPARENTLY USED BY W.H. RAYNER FOR SURVEY DATED NOVEMBER 4, 1867, FILED IN MISC. FIELD NOTES ON PAGE 30, BUT NO MONUMENT IS DESCRIBED AND NO WITNESSES SHOWN.
6. IN LARGE LEATHER BOUND BOOK TITLED "SURVEY MONUMENTS INGHAM COUNTY" KEPT BY LAVERNE J. HENDRYX LS #3276, (NOW IN POSSESSION OF MARK MINSHALL, ACCOLADE SURVEYING, INC. MASON) ON PAGE 12, T2N R2W CHAPTER, CALLS FOR A "IRON RAISED TO SURFACE WITH 3" OF GAS PIPE". NO WITNESSES ARE GIVEN. INFORMATION IS NOT DATED.
7. LAVERNE J. HENDRYX LS #3276 REPORTED USING CORNER IN SURVEY DATED MAY 16, 1973 IN LIBER 1 OF SURVEYS, PAGE 739 WITH NO MENTION OF MONUMENT OR WITNESSES.
8. CORNER RECORDED BY GEORGE M. YOUNG LS #17640 IN LIBER 3 OF CORNERS, PAGE 486 INGHAM COUNTY RECORDS ON CERTIFICATE DATED OCTOBER 29, 1975 AS A "FOUND 1" PIPE FLUSH WITH ASPHALT" WITH THE FOLLOWING WITNESSES:  
NAIL AND CAP IN P.P. N45°W, 64.29'  
NAIL AND CAP IN T.P. S35°W, 74.91'  
NAIL AND CAP IN 24" MAPLE, S45°E, 56.40'
9. GEORGE M. YOUNG LS #17640 REPORTED USING CORNER IN SURVEY DATED APRIL 17, 1976 AND RECORDED IN LIBER 2 OF SURVEYS, PAGE 825, AND RE-RECORDED IN LIBER 4 OF SURVEYS, PAGE 416, AND DID NOT MENTION MONUMENT OR WITNESSES, BUT NOTES "RECORDED - LIBER 3 PAGE 486".
10. RONNIE M. LESTER LS# 18998 REPORTED USING CORNER IN SURVEYS DATED NOVEMBER 25, 1991 AND RECORDED IN LIBER 6 OF SURVEYS, PAGES 851, 853, 855, AND 857 AS A 1/2" REBAR IN A MONUMENT BOX WITH THE FOLLOWING WITNESSES:  
CENTERLINE OF CONC. CASTING OF C.B. 191° AZ, 200.0'  
SE CORNER OF TELEPHONE CABLE BOX, 332° AZ, 63.1'  
SET NAIL AND TAG IN WEST SIDE UTILITY POLE, 351° AZ, 154.9'  
SET NAIL AND TAG IN NORTH SIDE 36" MAPLE, 104° AZ, 172.9'
11. DAVID R. LOHR LS #30090 REPORTED USING CORNER IN A SURVEY DATED MAY 29, 1992 AND RECORDED IN LIBER 6 OF SURVEYS, PAGES 968 AND 969 AS A FOUND 1/2" REBAR IN MONUMENT BOX WITH THE FOLLOWING WITNESSES:  
FD. NAIL AND TAG 24" OAK, S80°E, 173.25'  
NE COR. SIGN POST, N22°W, 48.10'  
SW COR. SIGN POST, S21°E, 53.50'  
CENTERLINE SIGN POST S45°W, 42.00'