

DEC 1 1997

COMMISSION

LAND CORNER RECORDATION CERTIFICATE  
Filing Requirement of Act 74, Mich. P.A. 1970

Liber 9 Page 237

For corners in

INGHAM  
(County)

Located in: WHEATFIELD TOWNSHIP  
Corner Code # \_\_\_\_\_

- 1. Public Land Survey      T 3N R 1E      A-3  
    T \_\_\_\_\_ R \_\_\_\_\_  
    T \_\_\_\_\_ R \_\_\_\_\_  
    T \_\_\_\_\_ R \_\_\_\_\_
- 2. Property Controlling    S \_\_\_\_\_ T \_\_\_\_\_ R \_\_\_\_\_  
    in Section                    S \_\_\_\_\_ T \_\_\_\_\_ R \_\_\_\_\_
- 3. Miscellaneous            S \_\_\_\_\_ T \_\_\_\_\_ R \_\_\_\_\_  
    Property in Sec.            S \_\_\_\_\_ T \_\_\_\_\_ R \_\_\_\_\_

FILED

976041158  
10/20/1997 13:41:39  
REGISTER OF DEEDS  
Paula Johnson  
INGHAM COUNTY, MI

Register of Deeds Stamp & File Number

- 4. Lot No. \_\_\_\_\_, Recorded Plat \_\_\_\_\_
- 5. Private Claims \_\_\_\_\_

I, RON HELSEL, in a field survey on JUNE 5, 1997, do hereby certify that under requirements of P.A. 74, Michigan P.A. of 1970, the corner points mentioned in lines 1 and 2 above were in conformance with regulations and rules therefore as required in the current manual of survey instructions of the United States Department of the Interior, Bureau of Land Management or by a decree of a Court of Law and /or that the corner points mentioned in lines 3, 4 and 5 above were in conformance with the rules of the Michigan Board of Land Surveyors or by a Decree of a Court of Law; established, re-established, monumented, re-monumented, recovered, found as expressed below:

NOTE: Not more than 4 corners, all in the same town and range, may be recorded on this certificate.

A. Description of original monument and accessories and/or subsequent restoration:  
ORIGINAL MONUMENT: POST SET BY J. WAMPLER, U.S. DEPUTY SURVEYOR, MAR. 3, 1826. WITNESSED AS: BEECH 8", S41E, 49 LINKS  
BEECH 18", N77E, 16 LINKS

- 1) FROM THE CETA REMON. DOSSIER, FOLDER 1, PAGE 11, W. H. RAYNER, COUNTY SURVEYOR, JUNE 23, 1865 CALLED FOR A BEECH 6", N59 1/2E, 86 LINKS; ELM 8", N78 1/4W, 68 1/2 LINKS. NO DESCRIPTION OF MONUMENT CITED.
- 2) FORM 280 FROM M.D.S.H, CIRCA 1960: 3/4" PIPE; 33" ELM, N52W, 40.11' (GONE)  
16" WALNUT, S48W, 59.35' (FOUND BEARING TREE)  
13" B. ELDER, N27E, 56.00' (GONE)
- 3) CONSUMERS POWER RECORDS AND THE INGHAM COUNTY ROAD COMMISSION GRID MAP CALL FOR THE SAME CORNER & WITNESSES AS ABOVE.
- 4) CORNER IDENTIFIED AS IRON IN JAMESTOWN PLAT, LIBER 27, PAGES 44-45, JAN. 6, 1967 BY MAX ROGERS R.L.S. #6637.  
(CONTINUED ON BACK)


B. Description of corner evidence found and/or method applied in restoring or reestablishing corner:  
FOUND THE 1/2" REROD ENCASED IN A 4" CONCRETE CYLINDER AND THE ORIGINAL WITNESSES DESCRIBED IN 5-A ABOVE. ACCEPTED THE POSITION OF THE REROD AS FAITHFUL PERPETUATION OF THE CORNER. LEFT MONUMENT AND CAP IN PLACE AND SET A STEEL COLLAR OVER THE CONCRETE COLLAR TO ROAD SURFACE.

C. Description of monument for corner and accessories established to perpetuate locating the position of the corner:  
1/2" REROD ENCASED IN 4" CONCRETE MONUMENT IN MON. BOX 2.0' EAST OF C/L MERIDIAN ROAD AND 1.0' SOUTH C/L OF LINN ROAD.  
FOUND NAIL AND TAG NO. 18998, W/SIDE 15" ELM, AZ. 26 DEG., 76.96'  
TOP NW CORNER 4" SQUARE CONCRETE HWY. R.O.W. MARKER, AZ. 121 DEG., 81.55 FEET  
CENTER OF 4" DIA. STEEL POST, AZ. 44 DEG., 38.36 FEET  
SET NAIL AND TAG NO. 18994, E/SIDE 30" WALNUT, AZ. 219 DEG., 68.44 FEET

	A	B	C	D	E	F	G	H	I	J	K	L
1												
2		6		5		4		3		2		
3												
4		7		8		9		10		11		1
5												
6		18		17		16		15		14		1
7												
8		19		20		21		22		23		2
9												
10		30		29		28		27		26		2
11												
12		31		32		33		34		35		3
13												

Signed by Ron Helsel  
Surveyor's Michigan License No. 18994

Date SEPT 27 1997

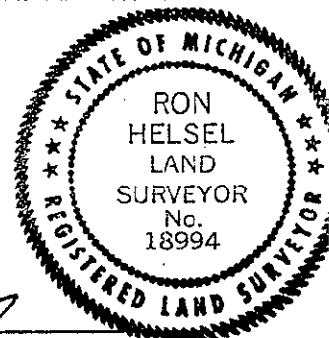

P.A. 345 INGHAM COUNTY  
PEER APPROVED: al, al, al, w

## A. (CONTINUED)

- 5) A L.C.R.C. WAS RECORDED IN LIBER 5, PAGE 210, FIELD DATED NOV. 9, 1978 BY R. LESTER, NO. 18998. "EXCAVATED A 10' X 16' HOLE TO AN AVERAGE DEPTH OF 2.2', AT THE INTERSECTION OF THE CENTER LINES OF LINN AND MERIDIAN ROADS. FOUND A 3/4" X 1.6' IRON PIPE WITH P.K. NAIL IN CENTER, IN UPRIGHT POSITION, 1" BELOW ROAD SURFACE, 1.0' SOUTH OF CENTERLINE OF LINN ROAD AND 2.0' EAST OF CENTERLINE OF MERIDIAN ROAD. FOUND RAILROAD SPIKE AT ROAD SURFACE, 4 FEET WEST OF CENTERLINE OF MERIDIAN ROAD AND ON CENTERLINE OF LINN ROAD. ACCEPTED 3/4" PIPE FOR CORNER....."  
"SET 4" X 36" CONCRETE MONUMENT WITH 1/2" X 38" REROD AND CAP # 18998 WITH CONCRETE COLLAR AND COVER....."  
FOUND NAIL AND TAG NO. 11370, EAST SIDE 30" WALNUT, SW, 68.97' (FOUND)  
3" IRON ANCHOR POST AT GROUND LEVEL, NE, 38.33' (FOUND)  
TOP NW CORNER 4" CONCRETE ROAD WAY MARKER, ESE, 81.56' (FOUND)  
NAIL & TAG, #18998, WEST SIDE 20" BOX ELDER, NE, 76.96' (FOUND ELM)
- 6) PLAT OF JAMESTOWN NO. 2, LIBER 45, PAGES 23-24, DATED NOV. 29, 1989 BY F.N. WHITE P.S. #12034 REFERRED TO THIS CORNER BY L.C.R.C. IN LIBER 5, PAGE 210.

FILED