

MEMORANDUM

DEC 1 2 1997

COMMISSIONER

LAND CORNER RECORDATION CERTIFICATE  
Filing Requirement of Act 74, Mich. P.A. 1970

Liber 9 Page 241

For corners in

INGHAM  
(County)

Located In: WHEATFIELD TOWNSHIP  
Corner Code # A-5

FILED

970041160  
10/20/1997 13:41:43  
REGISTER OF DEEDS  
Paula Johnson  
INGHAM COUNTY, MI

- 1. Public Land Survey T 3N R 1E A-5  
T \_\_\_\_\_ R \_\_\_\_\_  
T \_\_\_\_\_ R \_\_\_\_\_  
T \_\_\_\_\_ R \_\_\_\_\_
- 2. Property Controlling in Section S \_\_\_\_\_ T \_\_\_\_\_ R \_\_\_\_\_  
S \_\_\_\_\_ T \_\_\_\_\_ R \_\_\_\_\_
- 3. Miscellaneous Property in Sec. S \_\_\_\_\_ T \_\_\_\_\_ R \_\_\_\_\_  
S \_\_\_\_\_ T \_\_\_\_\_ R \_\_\_\_\_

Register of Deeds Stamp & File Number

- 4. Lot No. \_\_\_\_\_, Recorded Plat \_\_\_\_\_
- 5. Private Claims \_\_\_\_\_

	A	B	C	D	E	F	G	H	I	J	K	L	M
1													
2	6		5		4		3		2		1		
3													
4	7		8		9		10		11		12		
5													
6	16		17		16		15		14		13		
7													
8	19		20		21		22		23		24		
9													
10	30		29		28		27		26		25		
11													
12	31		32		33		34		35		36		
13													

I, RON HELSEL, in a field survey on JUNE 4, 1997 do hereby certify that under requirements of P.A. 74, Michigan P.A. of 1970, the corner points mentioned in lines 1 and 2 above were in conformance with regulations and rules therefore as required in the current manual of survey instructions of the United States Department of the Interior, Bureau of Land Management or by a decree of a Court of Law and /or that the corner points mentioned in lines 3, 4 and 5 above were in conformance with the rules of the Michigan Board of Land Surveyors or by a Decree of a Court of Law; established, re-established, monumented, re-monumented, recovered, found as expressed below:


NOTE: Not more than 4 corners, all in the same town and range, may be recorded on this certificate.

A. Description of original monument and accessories and/or subsequent restoration:  
ORIGINAL MONUMENT: POST SET BY J. WAMPLER, U.S. DEPUTY SURVEYOR, MAR. 3, 1826. WITNESSED AS: SUGAR 6", S66E, 6 1/2 LINKS  
LYNN 33", N59E, 46 LINKS

- 1) VOL. 2, PAGE 153, DATED JAN. 10-11, 1878, COUNTY SURVEYOR A. P. DRAKE IN A SURVEY OF SEC. 12 OF ALAIEDON TWP. GAVE A CALLING OF NORTH, 23.4 CHAINS FROM THE SE CORNER OF SECTION 12 TO THE NW CORNER OF SECTION 18, WHEATFIELD TOWNSHIP. HE DID NOT IDENTIFY OR GIVE WITNESSES TO THIS CORNER.
- 2) A L.C.R.C. WAS RECORDED IN LIBER 4, PAGE 99, DATED JUNE 9, 1977 BY G. YOUNG NO. 17640. "SET CORNER ON SECTION LINE 23.4 CHAINS NORTH OF NE CORNER OF SECTION 13, T3N, R1W." WITNESSED AS:  
#16 NAIL & CAP IN 40" MAPLE N10E, 279.41' (FOUND TREE)  
#16 NAIL & CAP IN ANCHOR POST S50E, 38.02' (GONE)  
SOUTH EDGE OF SOUTH DIRECTION SIGN POST N80W, 26.08' (FOUND NEW SIGN POST)
- 3) A SURVEY WAS RECORDED IN LIBER 3, PAGE 19 BY SURVEYOR YOUNG DATED JUNE 9, 1977. THE SURVEY CREATED A PARCEL IN THE SW 1/4 OF SECTION 18 OF WHEATFIELD TOWNSHIP AND THE CORNER WAS ESTABLISHED IN 2-A ABOVE WAS DETERMINED IN ORDER TO PRORATE THE WEST 1/4 CORNER OF SECTION 18.

B. Description of corner evidence found and/or method applied in restoring or reestablishing corner:  
EXCAVATED AND FOUND 1/2" IRON BAR AND CAP NO. 17640 8" BELOW THE SURFACE OF MERIDIAN ROAD. EXCAVATED DOWN THROUGH A SECOND LAYER OF ASPHALT AND GRAVEL TO THE CLAY SUB BASE. NATURAL GROUND TO THE WEST OF MERIDIAN ROAD IS ABOUT 3 FOOT HIGHER AND THE INTERSECTION APPEARS TO BE A CUT AREA. THE POSITION OF THE IRON BAR IS 8' FOOT SOUTH OF THE C/L OF NOBLE ROAD TO THE EAST AND ON C/L OF MERIDIAN ROAD. CORNER IN VERY CLOSE ACCORD TO BEING ON LINE WITH D-5 AND C-5 EXTENDED FROM THE EAST. ACCEPTED SURVEYOR YOUNG'S METHOD OF RE-ESTABLISHING AN OBLITERATED CORNER. REPLACED 1/2" BAR WITH 3/4" X 24" FORM PIN AND CAP STAMPED P.A. 345, P.S. NO. 18994 AND SET MONUMENT BOX TO ROAD GRADE.

C. Description of monument for corner and accessories established to perpetuate locating the position of the corner:  
3/4" FORM PIN AND CAP 8' SOUTH CENTERLINE OF NOBLE ROAD ON CENTERLINE OF MERIDIAN ROAD IN MONUMENT BOX.  
SET 1/2" X 18" IRON BAR AND CAP NO. 18994 5.5' WEST OF THE W/EDGE OF MERIDIAN ROAD, 6" DEEP, AZ. 273 DEG., 17.38 FEET  
SET 1/2" X 18" IRON BAR AND CAP NO. 18994 8.5' EAST OF SE'LY ROAD ARC, 6" DEEP, AZ. 122 DEG., 33.92 FEET  
SET NAIL AND TAG NO. 18994 E/SIDE 9" ELM, AZ. 349 DEG., 93.57 FEET  
SET NAIL AND TAG NO. 18994 W/SIDE 45" MAPLE, AZ. 12 DEG., 278.95 FEET

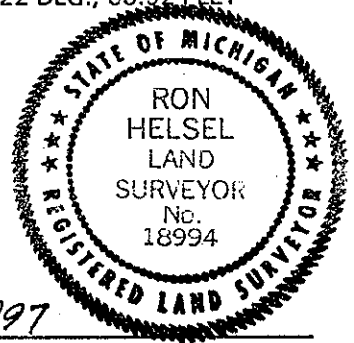

Signed by Ron Helsel  
Surveyor's Michigan License No. 18994

Date SEPT. 27, 1997

P.A. 345 INGHAM COUNTY  
PEER APPROVED 9/25/97 M