

DEC 17 1998

SECTION

LAND CORNER RECORDATION CERTIFICATE
Filing Requirement of Act 74, Mich. P.A. 1970

Liber 9 Page 331

For corners in

INGHAM
(County)

Located In: WHEATFIELD TOWNSHIP
Corner Code # _____

- 1. Public Land Survey T 3N R 1E A-6
- T R
- T R
- T R
- 2. Property Controlling S T R
- in Section S T R
- 3. Miscellaneous S T R
- Property in Sec. S T R

FILED

980047782
09/18/1998 13:20:25
REGISTER OF DEEDS
Paula Johnson
INGHAM COUNTY, MI

Register of Deeds Stamp & File Number

- 4. Lot No. _____, Recorded Plat _____
- 5. Private Claims _____

	A	B	C	D	E	F	G	H	I	J	K	L	M
1													
2	6		5		4		3		2		1		
3													
4	7		8		9		10		11		12		
5													
6	18		17		16		15		14		13		
7													
8	19		20		21		22		23		24		
9													
10	30		29		28		27		26		25		
11													
12	31		32		33		34		35		36		
13													


I, RON HELSEL, in a field survey on July 7, 1998 do hereby certify that under requirements of P.A. 74, Michigan P.A. of 1970, the corner points mentioned in lines 1 and 2 above were in conformance with regulations and rules therefore as required in the current manual of survey instructions of the United States Department of the Interior, Bureau of Land Management or by a decree of a Court of Law and /or that the corner points mentioned in lines 3, 4 and 5 above were in conformance with the rules of the Michigan Board of Land Surveyors or by a Decree of a Court of Law; established, re-established, monumented, re-monumented, recovered, found as expressed below:

NOTE: Not more than 4 corners, all in the same town and range, may be recorded on this certificate.

- A. Description of original monument and accessories and/or subsequent restoration:
CORNER WAS NOT SET IN ORIGINAL GOVERNMENT SURVEY.
- 1) LIBER 4, PAGE 99 OF CORNERS, DATED 6-9-77, G. YOUNG, P.S. # 17640, "SET CORNER ON SECTION LINE AT A PRORATED DISTANCE BETWEEN SW CORNER SECTION 19 & NW CORNER OF SECTION 18, T3N, R1E, SET 1/2" X 24" REROD AND CAP." # 16 NAIL & CAP IN 15" OAK, N30E, 87.15' (FOUND)
16 NAIL & CAP IN P.P., S85E, 144.13' (FOUND)
16 NAIL & CAP IN 15" OAK, S20E, 153.96' (FOUND)
 - 2) P.A. 132 SURVEY, LIBER 3, PAGE 19, DATED 6-18-1977 BY G. YOUNG CALLED FOR THE SAME WITNESSES AND CORNER AS ABOVE.
 - 3) P.A. 132 SURVEY, LIBER 7, PAGE 233-235, DATED 5-13-1993, BY D. LOHR P.S. #30090, "FOUND 1/2" IRON 2" DEEP, 5.5 FT. WEST OF C/L MERIDIAN RD.
RESET N&T 30090 24" OAK, N25E, 87.15' (FOUND)
FD. NAIL P.POLE, S85E, 144.13' (FOUND)
RESET N&T 30090 20" OAK, S11E, 153.96' (FOUND)
SET N&T 30090 12" OAK, S05W, 250.00' (FOUND)

B. Description of corner evidence found and/or method applied in restoring or reestablishing corner:
FOUND A 1/2" IRON BAR 5.5 FEET WEST OF THE CENTERLINE OF MERIDIAN ROAD ALONG WITH ALL OF THE WITNESSES DESCRIBED BY SURVEYORS LOHR AND YOUNG ABOVE. EXCAVATED DOWN THROUGH 3 LAYERS OF ASPHALT ABOUT 3 FEET TO THE CLAY ROAD BED. FOUND A 1/2" X 24" REROD UNDER THE 1/2" SMOOTH BAR AT THE ROAD SURFACE. DID NOT FIND ANY EVIDENCE OF A PREVIOUS CORNER. TRAVERSED FROM THE NORTHWEST CORNER OF SECTION 18 TO THE SOUTHWEST CORNER OF SECTION 13, T3N, R1W, (ALAIEDON TWP.) AND FOUND THE CORNER TO BE 0.24' NORTH OF THE MID POINT BETWEEN A-5 AND A-7 AND 0.06' WEST OF A LINE BETWEEN M-6 AND M-5 OF THE ALAIEDON TWP. STANDARD LINE. ACCEPTED THE POSITION OF THE 1/2" REROD AND SET A 3/4" BY 24" FORM PIN AND DISK STAMPED P.A. 345, P.S. NO. 18994 OVER TOP OF THE REROD AND ON THE STANDARD LINE IN A MONUMENT BOX.

- C. Description of monument for corner and accessories established to perpetuate locating the position of the corner:
3/4" X 24" FORM PIN AND INGHAM CO. DISK
SET NAIL AND TAG NO. 18994 ABOVE A NAIL AND TAG NO. 30090, E/SIDE 18" OAK, AZ. 185°, 249.95 FEET
SET NAIL AND TAG NO. 18994 ABOVE A NAIL AND TAG NO. 30090, W/SIDE 18" HICKORY, AZ. 171°, 218.81 FEET
SET NAIL AND TAG NO. 18994 ABOVE A NAIL AND TAG NO. 30090, W/SIDE 22" OAK, AZ 25°, 87.04 FEET
FOUND NAIL & TAG NO. 30090 S/SIDE POWER POLE, AZ. 93°, 144.08 FEET
SET NAIL AND TAG NO. 18994 W/SIDE 18" OAK, AZ. 169°, 153.97 FEET
MEASURED 2634.31 FEET TO A-5
MEASURED 2634.79 FEET TO A-7

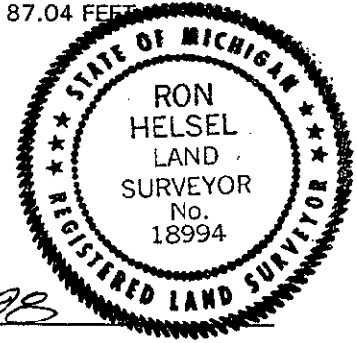

Signed by Ron Helsel
Surveyor's Michigan License No. 18994

Date Aug. 7, 1998

P.A. 345 INGHAM COUNTY
PEER APPROVED: 8/11/98 M