

DEC 16 1996

COMMISSION

LAND CORNER RECORDATION CERTIFICATE

Filing Requirement of Act 74, Mich. P.A. 1970

WHEATFIELD TOWNSHIP

FILED

960034294
09/06/1996 13:18:32
REGISTER OF DEEDS
Paula Johnson
INGHAM COUNTY, MI


For corners in

INGHAM
(County)

Located In:

Corner Code -##

- 1. Public Land Survey T 3N R 1E C-2
- T _____ R _____
- T _____ R _____
- T _____ R _____
- 2. Property Controlling S _____ T _____ R _____
- in Section S _____ T _____ R _____
- 3. Miscellaneous S _____ T _____ R _____
- Property in Sec. S _____ T _____ R _____
- 4. Lot No. _____, Recorded Plat _____
- 5. Private Claims _____

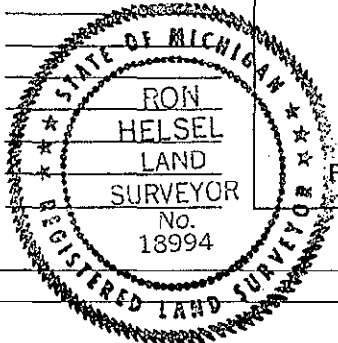

Register of Deeds Stamp & File Number

I, RON HESSEL, in a field survey on MAY 8, 19 96, do hereby certify that under requirements of P.A. 74, Michigan P.A. of 1970, the corner points mentioned in lines 1 and 2 above were in conformance with regulations and rules therefore as required in the current manual of survey instructions of the United States Department of the Interior, Bureau of Land Management or by a decree of a Court of Law and/or that the corner points mentioned in lines 3, 4 and 5 above were in conformance with the rules of the Michigan Board of Land Surveyors or by a Decree of a Court of Law; established, re-established, monumented, re-monumented, recovered, found as expressed below:

	A	B	C	D	E	F	G	H	I	J	K	L
2	6	5	4	3	2	1						
3												
4	7	8	9	10	11	12						
5												
6	18	17	16	15	14	13						
7												
8	19	20	21	22	23	24						
9												
10	30	29	28	27	26	25						
11												
12	31	32	33	34	35	36						

NOTE: Not more than 4 corners, all in the same town and range, may be recorded on this certificate.

A. Description of original monument and accessories and/or subsequent restoration:

- ORIGINAL MONUMENT: POST SET BY J. WAMPLER, U.S. DEPUTY SURVEYOR, MARCH, 1826.
BEECH 17" S34E, 16 LINKS
BEECH 11" N42W, 29 LINKS
- FROM INGHAM COUNTY DOSSIER, FOLDER 1, PAGE 1, DATED FEB. 18, 1901, E.A. CALKINS CO. SURVEYOR, ELM 6" N67 1/2E, 62 1/2 LINKS SURVEY ONLY APPLIED TO CORNERS AND DID NOT DESCRIBE MARKERS OR GIVE MEASUREMENTS.
 - A SURVEY WAS RECORDED IN LIBER 3, PGS. 578 & 579, DATED 11-3-77 BY A.S. PIERSON NO. 13039.

"CONTINUED ON BACK"

B. Description of corner evidence found and/or method applied in restoring or reestablishing corner:

FOUND DRIVE SHAFT AS DESCRIBED BY SURVEYOR STEADMAN IN EAST-WEST FENCE LINE. EXCAVATED 10 FEET WEST AND EAST ALONG FENCE LINES FROM THE SHAFT. DID NOT FIND ANY INDICATION OF THE CORNER. ACCEPTED THE DRIVE SHAFT AS SET BY STEADMAN AS A MARKER FOR THE CORNER. CORNER COMPUTED TO BE 2.13 FEET NORTH OF THE LINE BETWEEN D-2 (CENTER OF SEC. 5) AND A-2 (WEST 1/4 COR. OF SEC.6).

C. Description of monument for corner and accessories established to perpetuate locating the position of the corner:

4 FOOT BY 2" IRON DRIVE SHAFT WITH 6" BELL END WITH CAP LABELED P.A. 345, P.S. NO. 18994 AT GROUND LEVEL IN E-W FENCE LINE
SET NAIL & TAG NO. 18994 EAST/SIDE 20" BASSWOOD, AZ. 342°, 7.41'
SET NAIL & TAG NO. 18994 NORTH/SIDE 24" BASSWOOD, AZ. 260°, 14.02'
SET NAIL & TAG NO. 18994 NORTH/SIDE 24" OAK, AZ. 88°, 35.64'
SET NAIL & TAG NO. 18994 SOUTH/SIDE 8" OAK, AZ. 84°, 16.20'
SET NAIL & TAG NO. 18994 NW/SIDE 6" MAPLE, AZ. 47°, 10.42'
MEAS. WEST, 550.15 FEET TO A-2
MEAS. EAST, 2656.84 FEET TO D-2
MEAS. SOUTH, 2622.51 FEET TO C-3

Signed by

Ron Hesel

Date

Aug. 17, 1996

Surveyor's Michigan License No.

18994

P.A. 345 INGHAM COUNTY

PEER APPROVED: 8/22/96 RL

"A" CONTINUED

THE SURVEY ESTABLISHED AN EAST-WEST 1/4 LINE FROM THE WEST 1/4 CORNER OF SECTION 6 TO THE CENTER OF SECTION 5. THE VICINITY OF C-2 WAS LABELED AS APPROXIMATE SECTION LINE BETWEEN SEC. 5 & SEC. 6.

- 3) A L.C.R.C. WAS RECORDED IN LIBER 5, PAGE 140, DATED MAY 7, 1973 & RECORDED JAN. 16, 1979 BY R.W. STEADMAN NO. 11370. "FOUND ANCHOR POST AT THE 1/8 POST NEXT EAST AND AT THE CENTER OF THE SECTION NEXT EAST. PROJECTED THIS LINE WEST AND SET CORNER THE SAME DISTANCE WEST OF 1/8 POST THAT 1/8 POST IS WEST OF CENTER OF SECTION. CORNER FALLS IN EAST-WEST FENCE".
 "SET 2" IRON DRIVE SHAFT 4' LONG WITH 6" BELL END JUST ABOVE GROUND LEVEL TO MARK THIS CORNER."
 7" BASSWOOD N.W 7.73' (FOUND TREE)
 14" BASSWOOD W.SW 13.92' (FOUND TREE)
 14" OAK E.SE 35.85' (FOUND TREE)
- 4) A SURVEY WAS RECORDED IN LIBER 5, PAGES 506-507 BY R. LESTER P.S. NO. 18998, DATED SEPT. 8, 1988. HE RAN A LINE BETWEEN THE CENTER OF SECTION 5 AND THE WEST 1/4 COR. OF SEC. 6, AND IGNORED THIS CORNER.
- 5) A SURVEY WAS RECORDED IN LIBER 4, PAGES 1012-1013 BY R. LESTER, DATED MARCH 13, 1985. A LINE WAS RAN BETWEEN THE SAME CORNERS AS 4-A ABOVE.

Rcpt No	27477
CRNR	9.00
MSSR	2.00
Total	11.00