

**SURVEY &  
REMONUMENTATION**

DEC 16 1996

**COMMISSION**

**LAND CORNER RECORDATION CERTIFICATE**

Liber      8 Page      622

**Filing Requirement of Act 74, Mich. P.A. 1970**

WHEATFIELD TOWNSHIP

For corners in  
INGHAM  
(County)

Located In:      Corner Code ≠#

- |                                       |   |           |   |           |            |
|---------------------------------------|---|-----------|---|-----------|------------|
| 1. Public Land Survey                 | T | <u>3N</u> | R | <u>1E</u> | <u>E-1</u> |
|                                       | T | _____     | R | _____     | _____      |
|                                       | T | _____     | R | _____     | _____      |
|                                       | T | _____     | R | _____     | _____      |
| 2. Property Controlling<br>in Section | S | _____     | T | _____     | _____      |
|                                       | S | _____     | T | _____     | _____      |
| 3. Miscellaneous<br>Property in Sec.  | S | _____     | T | _____     | _____      |
|                                       | S | _____     | T | _____     | _____      |
4. Lot No. \_\_\_\_\_, Recorded Plat \_\_\_\_\_
5. Private Claims \_\_\_\_\_

**FILED**

960034293  
09/06/1996 13:18:30  
REGISTER OF DEEDS  
Paula Johnson  
INGHAM COUNTY, MI


**Register of Deeds Stamp & File Number**

I, RON HELSEL, in a field survey on NOVEMBER 14, 1995, do hereby certify that under requirements of P.A. 74, Michigan P.A. of 1970, the corner points mentioned in lines 1 and 2 above were in conformance with regulations and rules therefore as required in the current manual of survey instructions of the United States Department of the Interior, Bureau of Land Management or by a decree of a Court of Law and/or that the corner points mentioned in lines 3, 4 and 5 above were in conformance with the rules of the Michigan Board of Land Surveyors or by a Decree of a Court of Law; established, re-established, monumented, re-monumented, recovered, found as expressed below:

	A	B	C	D	E	F	G	H	I	J	K	L	M
2	6	5	4	3	2	1							
3													
4	7	8	9	10	11	12							
5													
6	18	17	16	15	14	13							
7													
8	19	20	21	22	23	24							
9													
10	30	29	28	27	26	25							
11													
12	31	32	33	34	35	36							
13													

**NOTE: Not more than 4 corners, all in the same town and range, may be recorded on this certificate.**

- A. Description of original monument and accessories and/or subsequent restoration:  
ORIGINAL MONUMENT: POST SET BY J. WAMPLER, U.S. DEPUTY SURVEYOR, MARCH 1826.  
INTERSECTED N. BOUNDRY 77 LINKS WEST OF POST 75.20 CHAINS N. OF SE COR. SEC.5.  
SUGAR 12" S52W, 11 LINKS  
BEECH 5" S32E, 4 LINKS  
1) DID NOT FIND ANY REFERENCE TO THIS CORNER IN EITHER PUBLIC OR PRIVATE RECORDS.
- B. Description of corner evidence found and/or method applied in restoring or reestablishing corner:  
EXCAVATED IN PROBABLE AREA NORTH & SOUTH OF AN EXISTING FENCE LINE ON THE CENTERLINE OF BURKLEY ROAD TO THE SOUTH WHICH WAS FOUND TO BE IN CLOSE ACCORD OF THE TWP. JOG & PHYSICAL CENTERLINE OF BURKLEY ROAD TO THE NORTH. FOUND SEVERAL STONES ENTWINED WITH TREE ROOTS ALONG WITH THE ROTTED REMAINS OF AT LEAST (3) PREVIOUS ANCHOR POSTS. COULD NOT SET A MARKER ON LINE BETWEEN THE STANDARD CORNERS 77 LINKS WEST OF E-13 BECAUSE OF A 3" STEEL BRACE FOR AN ANCHOR POST AND THE ENTWINED TREE ROOTS WITH STONES. SET A 3/4" FORM PIN AND CAP LABELED P.A. 345, P.S. #18994 3.00' SOUTH AND ON LINE WITH E-2 FROM A POINT 77 LINKS (50.82') WEST AND ON LINE BETWEEN D-13 AND E-13.
- C. Description of monument for corner and accessories established to perpetuate locating the position of the corner:  
3/4" X 24" FORM PIN & CAP #18994 3.00' SOUTH OF TOWNSHIP LINE.  
SET NAIL & TAG #18994 SOUTH SIDE TWIN PIGNUT AZ. 64°, 2.80'  
SET NAIL & TAG #18994 EAST SIDE 10" MAPLE AZ. 208°, 81.27'  
SET NAIL & TAG #18994 SOUTH SIDE POWER POLE AZ. 92°, 57.88'  
NE CORNER PORCH FND. AZ. 248°, 104.42'  
E-13 WILLIAMSTOWN TWP. AZ. 89°, 50.80'  
1/2" IRON PIPE IN MON. BOX AZ. 83°, 27.16'  
MEASURED 2287.92' TO E-2 (G.L.O. 2323.2') 35.2 CHAINS

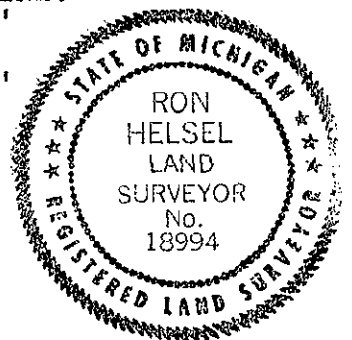

Signed by Ron Helsel Date NOV. 16, 1995  
Surveyor's Michigan License No. 18994