

FEB 22 1996

950003979 Liber 8

Page 582

COMMISSION

LAND CORNER RECORDATION CERTIFICATE
Filing Requirement of Act 74, Mich. P.A. 1970
WHEATFIELD TOWNSHIP

For corners in

INGHAM
(County)

Located In:

Corner Code #:

FILED

- 1. Public Land Survey T 3N R 1E E-2
 T _____ R _____
 T _____ R _____
 T _____ R _____
- 2. Property Controlling S _____ T _____ R _____
 in Section S _____ T _____ R _____
- 3. Miscellaneous S _____ T _____ R _____
 Property in Sec. S _____ T _____ R _____

NOV 29 9 53 AM '95

REGISTER OF DEEDS

INGHAM COUNTY, MICH.

Register of Deeds Stamp & File Number

- 4. Lot No. _____, Recorded Plat _____
- 5. Private Claims _____

	A	B	C	D	E	F	G	H	I	J	K	L	A
2	6		5	4	3								1
3													
4	7		8	9	10								12
5													
6	18		17	16	15								13
7													
8	19		20	21	22								24
9													
10	30		29	28	27								25
11													
12	31		32	33	34								36
13													

I, RON HELSEL, in a field survey on OCTOBER 13, 19 95, do hereby certify that under requirements of P.A. 74, Michigan P.A. of 1970, the corner points mentioned in lines 1 and 2 above were in conformance with regulations and rules therefore as required in the current manual of survey instructions of the United States Department of the Interior, Bureau of Land Management or by a decree of a Court of Law and/or that the corner points mentioned in lines 3, 4 and 5 above were in conformance with the rules of the Michigan Board of Land Surveyors or by a Decree of a Court of Law; established, re-established, monumented, re-monumented, recovered, found as expressed below:

NOTE: Not more than 4 corners, all in the same town and range, may be recorded on this certificate.

A. Description of original monument and accessories and/or subsequent restoration:

ORIGINAL MONUMENT: POST SET BY J. WAMPLER, U.S. DEPUTY SURVEYOR, MARCH 1826,

BEECH 16 N54W, 21 LINKS
 SUGAR 17 S79E, 19 1/2 LINKS

1) A L.C.R.C. WAS RECORDED BY L. HENDRYX #3276, JULY 6, 1976 IN LIBER 4, Pg. 87 HE SET A #4 IRON (1/2" REBAR).


GAS PIPE, E. 33.0' (FOUND)
 CENTER OF 7" OAK NNW, 43'-10"
 CENTER OF 4" HICKORY SE, 32'-3"
 (CONTINUED ON BACK)

B. Description of corner evidence found and/or method applied in restoring or reestablishing corner:

FOUND 8" X 1/2" REBAR IN MONUMENT BOX IN CENTERLINE OF BURKLEY ROAD. FOUND A 1/2" PIPE 33' EAST ON REMNANTS OF FENCE LINE TO EAST. ROTTED WOOD ANCHOR POST TO THE WEST. EXCAVATED AND FOUND A RIBBED 10" SPIKE OVER THE TOP OF A POINTED STONE 2.7 FEET DEEP. DIRECTLY BELOW THE 1/2" REBAR. ACCEPTED THE POSITION OF THE STONE AND REBAR AND SET 3/4" X 24" FORM PIN AND CAP LABELED P. ACT 345, P.S. 18994.

C. Description of monument for corner and accessories established to perpetuate locating the position of the corner:

3/4" FORM PIN & CAP IN CENTERLINE BURKLEY ROAD.
 SET NAIL & TAG #18994 SW/SIDE 8" ASPEN AZ. 143°, 32.38'
 SET NAIL & TAG #18994 NE/SIDE 20" OAK AZ. 339°, 33.90'
 SET NAIL & TAG #18994 S/SIDE 8" ELM AZ. 277°, 24.29'
 FOUND 1/2" PIPE EAST, 33.01'
 CENTERLINE STEEL GATE POST AZ. 40°, 56.40'
 CENTERLINE STEEL GATE POST AZ. 79°, 41.02'
 MEASURED 2631.71' TO E3

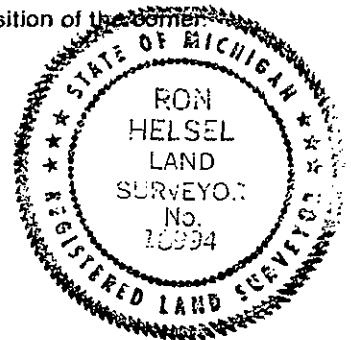

Signed by

Ron Helsel

Date NOV. 6, 1995

Surveyor's Michigan License No. 18994

P.A. 345 INGHAM COUNTY
PEER APPROVED 11/7/95 *M*

"A" CONTINUED

(NOTE: DID NOT FIND HENDRYX SURVEY(S) IN PRIVATE OR PUBLIC RECORDS REFERENCED TO THIS CORNER.)

- 2) A SURVEY WAS RECORDED IN LIBER 5, PAGE 125, DATED MAY 29, 1986 BY D. R. LC #30090. HE ONLY CITED LIBER 4, PG. 87 L.C.R.C. ABOVE.
- 3) A SURVEY WAS RECORDED IN LIBER 5, PAGES 405-406, DATED DEC. 1987, BY G. M. YOUNG #17640. HE CITED THE SAME WITNESSES AS "1-A" ABOVE.
- 4) A SURVEY WAS RECORDED IN LIBER 5, PAGES 824-825, DATED MAY 31, 1990 BY M. F. FOUTY #18989. HE ONLY CITED LIBER 4, PG. 87 L.C.R.C. ABOVE.