

**SURVEY &  
REMONUMENTATION**

DEC 0 3 1999

Liber 9 Page 466

**FILED**

990043530  
08/26/1999 09:07:48  
REGISTER OF DEEDS  
Paula Johnson  
INGHAM COUNTY, MI

**SECTION**

**LAND CORNER RECORDATION CERTIFICATE  
Filing Requirement of Act 74, Mich. P.A. 1970  
WHEATFIELD**

For corners in

<u>INGHAM</u> (County)	Located In:	Corner Code #
1. Public Land Survey	T <u>3N</u> R <u>1E</u>	<u>F-3</u>
	T _____ R _____	_____
	T _____ R _____	_____
	T _____ R _____	_____
2. Property Controlling in Section	S _____ T _____ R _____	_____
	S _____ T _____ R _____	_____
3. Miscellaneous Property in Sec.	S _____ T _____ R _____	_____
	S _____ T _____ R _____	_____

Register of Deeds Stamp & File Number

4. Lot No. \_\_\_\_\_, Recorded Plat \_\_\_\_\_  
5. Private Claims \_\_\_\_\_

I, RON HELSEL, in a field survey on AUG. 7, 1999 do hereby state that under requirements of P.A. 74, Michigan P.A. of 1970, the corner points mentioned in lines 1 and 2 above were in conformance with regulations and rules therefore as required in the current manual of survey instructions of the United States Department of the Interior, Bureau of Land Management or by a decree of a Court of Law and /or that the corner points mentioned in lines 3, 4 and 5 above were in conformance with the rules of the Michigan Board of Land Surveyors or by a Decree of a Court of Law; established, re-established, monumented, recovered, found as expressed below:

	A	B	C	D	E	F	G	H	I	J	K	L	M
1													
2	6		5		4		3		2		1		
3						●							
4	7		8		9		10		11		12		
5													
6	18		17		16		15		14		13		
7													
8	19		20		21		22		23		24		
9													
10	30		29		28		27		26		25		
11													
12	31		32		33		34		35		36		
13													

NOTE: Not more than 2 corners, all in the same town and range, may be recorded on this certificate.

A. Description of original monument and accessories and/or subsequent restoration:

ORIGINAL MONUMENT: POST SET J. WAMPLER, U.S. DEPUTY SURVEYOR, MAR., 1826. WEST CORRECTED 39.91 CHAINS; BEECH, 11", N24-1/2W, 18 LINKS; BEECH 16", S21E, 18-1/2 LINKS.


- 1) VOL. 2, PAGE 93, T.J. BROWN, CO. SURVEYOR, MAR. 21, 1873, CALLED FOR A STONE, FROM WHICH A BEECH 12", BEARS S27°W, 62.5 LINKS.
- 2) I.C.R.C GRID MAP CALLED FOR A 1" PIPE. ANCH. POST NORTH, 28.81 FEET (NOW GONE); ANCH. POST SOUTH, 27.94 FEET (NOW GONE); T. POLE, N56°E, 48.62 FEET (FOUND POWER POLE).
- 3) P.A. 74, L.C.R.C, LIBER 3, PAGE 77, M. FOUTY, P.S. NO. 18989, APRIL 22, 1974. "FOUND 1" IRON PIPE BURIED 6" IN CENTERLINE OF LINN RD. M.D.S.H. RECORDS AND WITNESSES. (I DID NOT OBTAIN OR FIND ANY M-DOT RECORDS PERTAINING TO THIS CORNER AND SURVEYOR FOUTY USED THE I.C.R.C. WITNESSES FROM ABOVE). 1/2" BAR WITH IDENTIFICATION CAP S02°29'32"E, 33.01'; NAIL & TAG IN W SIDE 6" PINE, SSW, 60.94'; NAIL & TAG IN UTILITY POLE NW, 48.16 FEET.
- 4) P.A. 132 SURVEY, LIBER 2, PAGES 690-691, M. FOUTY, DATED DEC1, 1975, CALLED FOR THE SAME WITNESSES AS 2-A ABOVE.
- 5) P.A. 132 SURVEY, LIBER 3, PAGES 562-563, M. FOUTY, DATED OCT. 21, 1978, CALLED FOR A BOAT SPIKE OVER 1" PIPE WITH SAME WITNESSES AS 2-A ABOVE.

B. Description of corner evidence found and/or method applied in restoring or reestablishing corner:

FOUND A BOAT SPIKE IN THE CENTERLINE OF LINN ROAD ON A FIELD LINE TO THE NORTH. EXCAVATED AND FOUND A RR SPIKE UNDER THE BOAT SPIKE OVER TOP OF A HORIZONTAL 1" PIPE ABOUT 15" DEEP. 6" BELOW THE PIPE HIT A MASSIVE STONE AND COULD NOT DIG FURTHER. FOUND FOUTY'S NAIL AND TAG IN A VERY OLD POWER POLE WHICH I BELIEVE IS THE SAME POLE WITNESSED BY THE INGHAM CO. ROAD COMM. HE CALLED FOR THE POLE TO BE NW, BUT I BELIEVE HE MEANT NE. ACCEPTED THE POSITION OF THE BOAT SPIKE AND SET A 3/4" X 20" IRON BAR ON TOP OF THE STONE WITH A STANDARD 2.5" ALUM. DISK STAMPED P.A. 345, P.S. 18994 IN A MONUMENT BOX.

C. Description of monument for corner and accessories established to perpetuate locating the position of the corner:

3/4" IRON BAR AND INGHAM COUNTY DISK IN MONUMENT BOX IN C/L LINN ROAD  
SET NAIL & TAG NO. 18994 ABOVE THE FOUTY N&T, SE/SIDE POWER POLE, AZ. 62°, 48.19 FEET  
SET NAIL & TAG NO. 18994 NORTH/SIDE 38" WILLOW, AZ. 237°, 77.64 FEET  
SET NAIL & TAG NO. 18994 EAST/SIDE 18" NORTHERN HACKBERRY, AZ. 185°, 75.97 FEET  
SET NAIL & TAG NO. 18994 EAST/SIDE 16" PINE, AZ. 215°, 60.24 FEET  
SOUTH, 33.01 FEET TO BAR & CAP NO. 18989

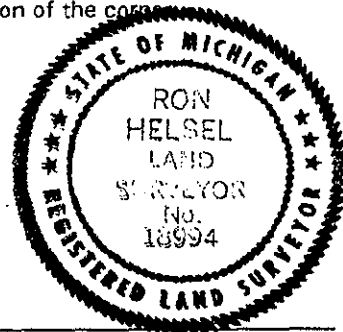

Signed by Ron Helsel  
Surveyor's Michigan License No. 18994

Date Aug. 21, 1999