

DEC 1 1993

COMMISSION LAND CORNER RECORDATION CERTIFICATE Filing Requirement of Act 74, Mich. P.A. 1970

LIBER 8 PAGE 51 FILED

For corners in

INGHAM (County) Located in: Corner Code 77
1. Public Land Survey T 3N R 1E G-10
2. Property Controlling in Section S T R
3. Miscellaneous Property in Sec. S T R
4. Lot No. Recorded Plat
5. Private Claims

Nov 24 9 04 AM '93

REGISTER OF DEEDS INGHAM COUNTY, MICH.

Register of Deeds Stamp & File Number

WHEATFIELD

Grid table with columns A-M and rows 2-13. A dot is marked at row 10, column D.

MAURICE H. MAHIEU, in a field survey on OCTOBER 5, 1993, do hereby certify that under requirements of P.A. 74, Michigan P.A. of 1970, the corner points mentioned in lines 1 and 2 above were in conformance with regulations and rules therefor as required in the current manual of survey instructions of the United States Department of the Interior, Bureau of Land Management or by a decree of a Court of Law and/or that the corner points mentioned in lines 3, 4 and 5 above were in conformance with the rules of the Michigan Board of Land Surveyors or by a Decree of a Court of Law, established, re-established, monumented, re-monumented, recovered, found as expressed below:

NOTE: Not more than 4 corners, all in the same town and range, may be recorded on this certificate.

A. Description of original monument and accessories and/or subsequent restoration:

- 1. ORIGINAL CORNER SET IN FEBRUARY 1826 BY JOSEPH WAMPLER D.S. WITNESSED BY: 8" BEECH S 34° E 26 LKS 14" LYNN N 50° W 27 1/2 LKS 12" SUGAR S 79 1/2° W 19 LKS
2. CORNER WAS NOTED IN SURVEY BY W. H. RAYNER ON JANUARY 16, 1867 - NO INDICATION OF THE MONUMENTATION. WITNESSES ARE: 10" W.A. N 78 1/2° E 58 1/2 LINKS 14" LYNN N 52° W 28 LINKS


(CONTINUED ON BACK)

B. Description of corner evidence found and/or method applied in restoring or reestablishing corner:

A 1/2" IRON ROD WAS FOUND IN THE LOCATION AS CALLED FOR ON THE L.C.R.C. BY L. BRYAN. BASE OF FENCE POST IS SURROUNDED BY MANY STONES AND IS A DEPRESSED AREA. AREAS TO NORTH, SOUTH, EAST AND WEST ARE FARMED AND DOES NOT HAVE ANY OTHER INDICATION OF ALTERNATIVE LOCATIONS. OCCUPATION OF PROP. LINES INDICATE ROD IS AT LOCATION OF POSITION OF CORNER.

C. Description of monument for corner and accessories established to perpetuate locating the position of the corner: FOUND 1/2" IRON ROD, WITNESSED BY:

- 1. METAL NAIL AND TAG #28414, EAST SIDE 15" ELM S10° E 12.05 FEET
2. METAL NAIL AND TAG #25832, EAST SIDE WOOD FENCE CORNER POST, SOUTH 1.10 FEET
3. METAL NAIL AND TAG #28414, NORTH SIDE 24" HICKORY, WEST 143.10 FEET
4. METAL NAIL AND TAG #28414, WEST SIDE WOOD FENCE POST, NORTH 60.60 FEET

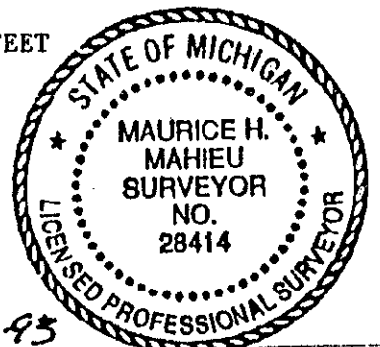

Signed by Maurice H. Mahieu Date 11-22-93
Surveyor's Michigan License No. 28414

2566

P.A. 345 INGHAM COUNTY PEER APPROVED 11/9/1993 RL

3. NOTED IN SURVEY IN NOVEMBER 13, 1874 (VOL. 3, PAGE 90) BY COUNTY SURVEYOR T. J. BROWN AS A POST, WITNESSED BY: 14" LYNN N 50° W 27 1/2 LINKS
4. SURVEY BY JOHN MCCLEARY, SURVEYOR IN DECEMBER 19, 20, 21, 1899 (VOL. 4, PAGE 35 & 35). THE ORATION OF THE SURVEY WHICH THIS CORNER IS NOTED IS LENGTHY AND DETAILED ON THE REASONING AND METHOD FOR ACCEPTANCE OF EACH CORNER. THE WEST 1/4 CORNER WAS NOTED AS A PERPETUATION OF THE CORNER IN A SURVEY BY BROWN (SEE A-3 ABOVE). THE CORNER IS NOTED AS A STONE WITNESSED BY: 5" ASH S 87 1/2° W 104 1/2 LKS.
5. CORNER IS NOTED IN E. A. CALKINS, COUNTY SURVEYOR'S NOTES DATED FEBRUARY 18, 1901, IN FOLDER 1, PAGE 2, AS A STONE WITNESSED BY: 5" ASH S 87 1/2° W 104 1/2 LKS  
14" LYNN N 50° W 27 1/2 LKS.
6. CORNER WAS RECORDED BY LARRY A BRYAN (PS #25832) ON AUGUST 9, 1988. L.C.R.C. LIBER 7, PAGE 58 STATES: G-10 SET 1/2" BAR AND CAP ON NORTH SIDE OF OLD ANCHOR POST, FENCE LINES NORTH, SOUTH, AND EAST, WEST.  
WITNESSED BY: SET NAIL AND TAG #25832 EAST SIDE CORNER POST, SOUTH 1.10'  
SET NAIL AND TAG #25832 NORTH SIDE 20" HICKORY, WEST 143.15'  
SET NAIL AND TAG #25832 WEST SIDE 10" ELM, SOUTH 10° EAST 11.90'
7. CORNER IS NOTED SAME AS A-6 ABOVE ON SURVEY BY LARRY A. BRYAN, CERTIFIED SURVEY 3898, LIBER 6, PAGE 329.