

NOV 30 1993

COMMISSION

LAND CORNER RECORDATION CERTIFICATE
Filing Requirement of Act 74, Mich. P.A. 1970

Nov 3 10 47 AM '93
REGISTER OF DEEDS
INGHAM COUNTY, MICH.

For corners in

Form with fields for County (INGHAM), Located In, Corner Code (H-11), and numbered sections 1-5 for Public Land Survey, Property Controlling, Miscellaneous, Lot No., and Private Claims.

Register of Deeds Stamp & File Number

WHEATFIELD

Grid table with columns A-M and rows 2-13, containing numbers 1-36 and a black dot at row 11, column H.

MAURICE H. MAHIEU in a field survey on SEPT. 11, 19 93 do hereby certify that under requirements of P.A. 74, Michigan P.A. of 1970, the corner points mentioned in lines 1 and 2 above were in conformance with regulations and rules therefore as required in the current manual of survey instructions of the United States Department of the Interior, Bureau of Land Management or by a decree of a Court of Law and/or that the corner points mentioned in lines 3, 4 and 5 above were in conformance with the rules of the Michigan Board of Land Surveyors or by a Decree of a Court of Law; established, re-established, monumented, re-monumented, recovered, found as expressed below:

NOTE: Not more than 4 corners, all in the same town and range, may be recorded on this certificate.

A. Description of original monument and accessories and/or subsequent restoration:

- 1. ORIGINAL POST WAS SET IN MARCH OF 1826 BY JOSEPH WAMPLER WITNESSED BY: BEECH 8" S8W 22LKS DO. 12" N27W 19LKS
2. A GAS PIPE WAS NOTED AS THE CORNER BY JOHN MCCREARY COUNTY SURVEYOR IN NOTES DATED DEC. 19-22, 1899 IN VOLUME 4, PAGE 34-35 OF COUNTY SURVEYORS RECORDS. NARRATIVE FOR THIS CORNER DESCRIBED THE CORNER AS BEING FOUND AND ACCEPTED AS CORNER AND BEING IN "RIGHT LINE AND EQUI DISTANCE BETWEEN SECTION CORNER" WITNESSED BY: ELM 5 S56E 67LKS CEDAR 1 S86W 28 1/2LKS

(CONTINUED ON BACK)


B. Description of corner evidence found and/or method applied in restoring or reestablishing corner:

FOUND 4" DIAMETER CONCRETE MONUMENT WITH 1/2" REROD AND CAP AS NOTED IN A-5. THE NUMBERS ON CAP WERE UNREADABLE. THE ELM AND THE SQUARE FENCE POST WITNESSES OF A-5 WERE GONE. THE MULBERRY AND MAPLE WITNESSES OF A-5 WERE FOUND AND CHECK THE CORRECT DISTANCE TO THE FOUND CONCRETE MONUMENT. THE CONCRETE MONUMENT IS ACCEPTED AS THE CORNER BASED ON THE HISTORY OF THE GAS PIPE (A-2). MONUMENT IS 5' WEST OF CENTERLINE OF ZIMMER ROAD.

C. Description of monument for corner and accessories established to perpetuate locating the position of the corner:

THE 4" DIAMETER CONCRETE MONUMENT WAS LEFT IN POSITION AND WITNESSED BY:

- SET NAIL AND TAG #28414 SOUTH SIDE TWIN 18" MAPLE N 83°W 27.25 FEET
SET NAIL AND TAG #28414 NORTH SIDE 24" MULBERRY S 41°W 39.65 FEET
SET NAIL AND TAG #28414 EAST SIDE 10" MAPLE S 5°W 111.88 FEET
SET NAIL AND TAG #28414 WEST SIDE 10" MAPLE S 37°E 55.69 FEET

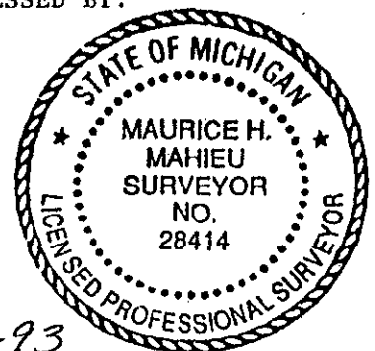

Signed by Maurice H. Mahieu Date 10-28-93
Surveyor's Michigan License No. 28414

3. CORNER REMONUMENTED WITH A RAILROAD SPIKE SHANK IN A PRIVATE LAND SURVEY BY C. STEPHENS (R.L.S. #3829) DATED JAN. 3, 1969.  
WITNESSED BY: NAIL AND TAG SOUTH SIDE POWER POLE NE 44.0 FEET  
NAIL AND TAG SOUTH SIDE 6" OAK WNW 34.17 FEET  
NAIL AND TAG WEST SIDE 14" BIRCH SSE 89.31 FEET
4. INGHAM COUNTY ROAD COMMISSION NOTED THE SAME MONUMENTATION AND WITNESSES AS A-3 ABOVE. DATE OF ICRC RECORD IS JAN. 1, 1969.
5. CORNER WAS RECORDED IN L.C.R.C. IN LIBER 5, PAGE 75 BY RONNIE M. LESTER (PLS #18998) DURING THE INGHAM COUNTY SURVEY AND REMONUMENTATION PROJECT OF 1978. THE C.R.C. DESCRIBED THE PROCEDURE OF UNCOVERING THE CORNER. THE RAILROAD SPIKE (A-3 ABOVE) WAS FOUND 6.0' EAST OF FOUND 1" GAS PIPE (A-2 ABOVE). THE GAS PIPE WAS ACCEPTED AS CORNER AND A 4" x 36" CONCRETE MONUMENT WITH 1/2" x 38" REROD WITH CAP #18998 WAS SET IN THE SAME POSITION AS THE GAS PIPE. THE CONCRETE MONUMENT WAS WITNESSED BY:  
  
NAIL AND TAG #18998 SOUTHWEST SIDE 8" MULBERRY, SW 39.98 FEET  
NAIL AND TAG #18998 SOUTH SIDE 14" MAPLE, WEST, 27.14 FEET  
NAIL AND TAG #18998 SOUTH SIDE SQUARE FENCE POST, EAST, 37.64 FEET  
NAIL AND TAG #18998 NORTHWEST SIDE 6" ELM N.E. 39.86 FEET
6. CORNER IS SHOWN ON ACT 132 CERTIFICATE OF SURVEY RECORDED IN LIBER 5, PAGE 1220 BY DOUGLAS K. RICHARDSON L.L.S. #31063 AS CONCRETE MONUMENT AS RECORDED IN L.C.R.C. LIBER 5, PAGE 75, DATED JUNE 89.