

DEC 14 1993

COMMISSION

LAND CORNER RECORDATION CERTIFICATE  
Filing Requirement of Act 74, Mich. P.A. 1970

LIBER 8 PAGE 45  
FILED

For corners in

<u>INGHAM</u> (County)	Located In:	Corner Code //
1. Public Land Survey	T 3N R 1E	J-9
	T _____ R _____	_____
	T _____ R _____	_____
	T _____ R _____	_____
2. Property Controlling in Section	S _____ T _____ R _____	_____
	S _____ T _____ R _____	_____
3. Miscellaneous Property in Sec.	S _____ T _____ R _____	_____
	S _____ T _____ R _____	_____
4. Lot No. _____, Recorded Plat _____		
5. Private Claims _____		

Nov 24 9 03 AM '93

REGISTER OF DEEDS  
*Paul Johnson*  
INGHAM COUNTY, MICH.

Register of Deeds Stamp & File Number

WHEATFIELD

A	B	C	D	E	F	G	H	I	J	K	L	M
2	6	5	4	3	2	1						
3												
4	7	8	9	10	11	12						
5												
6	18	17	16	15	14	13						
7												
8	19	20	21	22	23	24						
9												
10	30	29	28	27	26	25						
11												
12	31	32	33	34	35	36						
13												

I, MAURICE H. MAHIEU, in a field survey on SEPTEMBER 21, 19 93, do hereby certify that under requirements of P.A. 74, Michigan P.A. of 1970, the corner points mentioned in lines 1 and 2 above were in conformance with regulations and rules therefore as required in the current manual of survey instructions of the United States Department of the Interior, Bureau of Land Management or by a decree of a Court of Law and/or that the corner points mentioned in lines 3, 4 and 5 above were in conformance with the rules of the Michigan Board of Land Surveyors or by a Decree of a Court of Law; established, re-established, monumented, re-monumented, recovered, found as expressed below:

NOTE: Not more than 4 corners, all in the same town and range, may be recorded on this certificate.

A. Description of original monument and accessories and/or subsequent restoration:

1. THE ORIGINAL MONUMENT WAS A POST SET IN MARCH 1826 BY JOSEPH WAMPLER, WITNESSED BY:  
BEECH 9" S 48° W 11 LKS  
DO 15" W 27° W 9 LKS
2. CORNER USED BY T. J. BROWN ON JANUARY 19, 1876 IN LIBER 3, PAGE 114 OF COUNTY SURVEYORS RECORDS WITNESSED BY: HICKORY 12" N 60° E 52 1/2 LKS  
ELM 10" S 61 1/2° E 70 LKS


(CONTINUED ON BACK)

B. Description of corner evidence found and/or method applied in restoring or reestablishing corner:

FOUND BOAT SPIKE IN CENTERLINE OF FROST ROAD WITH FENCE LINE TO NORTH. REMOVE SPIKE AND DUG HOLE 4 FEET x 4 FEET x 1 FOOT DEEP TO LOCATE ANY OLD MONUMENTATION. DID NOT FIND ANY. COUNTY SURVEYORS SURVEY A-2 GIVE DIMENSION FROM THIS CORNER AND CORNER TO WEST AS 39.94 CHS (2,636.04). I MEASURED 2,638.02. I FEEL THAT THE BOAT SPIKE IS THE LOCATION OF THE CORNER BASED ON THIS IS THE SAME TYPE OF MONUMENTATION USED IN THIS AREA THAT WAS SET BY AN UNKNOWN SOURCE, AND THAT IT MEASURES IN CLOSE ACCORD WITH OLD COUNTY SURVEYORS RECORD. FROST ROAD IS GRAVEL AND HAS BEEN CUT DOWN IN THIS AREA FROM THE SURROUNDING AREA WHICH WOULD CAUSE OLD MONUMENTATION TO BE OBLITERATED.

C. Description of monument for corner and accessories established to perpetuate localing the position of the corner:

SET 3/4" x 24" SOLID STEEL BAR IN THE LOCATION OF THE FOUND BOAT SPIKE, WITNESSED BY:  
FOUND NAIL AND TAG "STEPHENS" EAST SIDE TELEPHONE POLE N 6° E 21.87'  
SET NAIL AND TAG #28414, NORTH SIDE 12" ELM S 59° W 40.68'  
SET NAIL AND TAG #28414, NORTH SIDE 14" ELM S 65° E 53.34'  
S.E. CORNER OF HOUSE #1745 FOUNDATION N 18° W 103.53 FEET

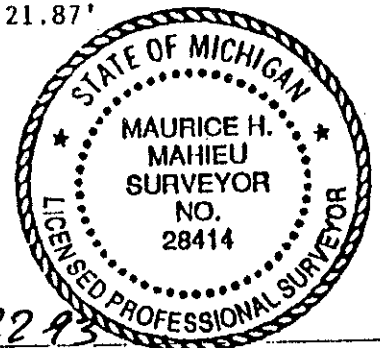

Signed by Maurice H. Mahieu

Date 11-22-93

Surveyor's Michigan License No. 28414

2563

P.A. 345 INGHAM COUNTY  
PEER APPROVED 11/23/93 *pu*

2563

3. CORNER RECORDED IN LCRC LIBER 3, PAGE 69 BY RONNIE LESTER (P.S. 18998) AS FOUND BOATSPIKE IN CENTERLINE OF FROST ROAD ON FENCE LINE TO NORTH. "MEASURED DISTANCES EAST AND WEST IN CLOSE ACCORD WITH ORIGINAL GOVERNMENT MEASUREMENTS." WITNESSES:  
 S.E. CORNER OF FOUNDATION NNW 103.47'  
 NAIL AND TAG EAST SIDE POWER POLE NORTH 21.68'  
 NAIL AND TAG NORTH SIDE 6" PINE SW 109.05'
4. CORNER USED ON SURVEY BY RONNIE LESTER (P.S. #18998) IN PA 132 SURVEY IN LIBER 1, PAGE 1192. USED SAME MONUMENTATION AND WITNESSES AS A-3. DATED 6-11-73
5. CORNER USED ON SURVEY BY DOUGLAS RICHARDSON (P.S. 31603) IN PA 132 SURVEY IN LIBER 5, PAGE 307. USED REFERENCE TO A-3. DATED JANUARY 20, 1987
6. CORNER USED ON SURVEY BY MYSELF (P.S.#28414) IN 1990 ON PA 132 SURVEY IN LIBER 6, PAGE 320. CALLED FOR BOAT SPIKE IN CENTERLINE OF FROST ROAD, WITNESSED BY:  
 NAIL & TAG #17640 NORTH SIDE 12" ELM S 55° E 53.46'  
 NAIL & TAG #17640 NORTH SIDE 12" ELM S 75° W 58.24'  
 NAIL & TAG #17640 NORTH SIDE 8" ELM S 50° W 40.74'  
 NAIL & TAG (STEPHENS ENG.) EAST SIDE UTILITY POLE NORTH 21.80'  
 MEASUREMENT TO EAST = 2,654.18'