

NOV 30 1993

COMMISSION

LAND CORNER RECORDATION CERTIFICATE
Filing Requirement of Act 74, Mich. P.A. 1970

Nov 3 10 48 AM '93

For corners in

REGISTER OF DEEDS
INGHAM COUNTY, MICH.

<u>INGHAM</u> (County)	Located In:	Corner Code <u>11</u>
1. Public Land Survey	T <u>3N</u> R <u>1E</u>	<u>K-9</u>
	T _____ R _____	_____
	T _____ R _____	_____
	T _____ R _____	_____
2. Property Controlling in Section	S _____ T _____ R _____	_____
	S _____ T _____ R _____	_____
3. Miscellaneous Property in Sec.	S _____ T _____ R _____	_____
	S _____ T _____ R _____	_____

Register of Deeds Stamp & File Number

- 4. Lot No. _____, Recorded Plat _____
- 5. Private Claims _____

WHEATFIELD

	A	B	C	D	E	F	G	H	I	J	K	L
2	6	5	4	3	2							
3												
4	7	8	9	10	11							
5												
6	18	17	16	15	14							
7												
8	19	20	21	22	23							
9												
10	30	29	28	27	26							
11												
12	31	32	33	34	35							
13												

I, MAURICE H. MAHIEU, in a field survey on SEPTEMBER 18 1993, do hereby certify that under requirements of P.A. 74, Michigan P.A. of 1970, the corner points mentioned in lines 1 and 2 above were in conformance with regulations and rules therefore as required in the current manual of survey instructions of the United States Department of the Interior, Bureau of Land Management or by a decree of a Court of Law and/or that the corner points mentioned in lines 3, 4 and 5 above were in conformance with the rules of the Michigan Board of Land Surveyors or by a Decree of a Court of Law; established, re-established, monumented, re-monumented, recovered, found as expressed below:

NOTE: Not more than 4 corners, all in the same town and range, may be recorded on this certificate.

A. Description of original monument and accessories and/or subsequent restoration:

1. ORIGINAL CORNER WAS A 11" BEECH TREE AS IDENTIFIED BY JOSEPH WAMPLER DATED MARCH 1826. NO WITNESSES WERE GIVEN.
2. COUNTY SURVEYOR A. JACKSON IDENTIFIED CORNER AS 11" BEECH (SAME AS A-1) ON JANUARY 31, 1853 IN VOL. 2, PAGE 134. NO WITNESSES WERE GIVEN.
3. CORNER REFERRED TO IN A SURVEY BY J. MULLETT, COUNTY SURVEYOR, DATED APRIL 1888 (VOL. 2, PAGE 135). CORNER IS THE 11" BEECH AND NO WITNESSES GIVEN.

(CONTINUED ON BACK)


B. Description of corner evidence found and/or method applied in restoring or reestablishing corner:

A 4" x 36" CONCRETE MONUMENT WITH A 1/2" IRON ROD AND CAP #18998 WAS FOUND IN THE INTERSECT OF FROST AND WILLIAMSTON ROADS. THE CONCRETE CORNER POST TO S.W. AND TELEPHONE POLE TO EAST WITNESSES FROM L.C.R.C. REFERRED IN A-5 WERE ALSO FOUND AND MEASURES IN CLOSE ACCORD WITH A-WITNESSES. BASED ON A-5, THE FOUND CONCRETE MONUMENT WAS ACCEPTED AS THE BEST LOCATION FOR THIS CORNER.

C. Description of monument for corner and accessories established to perpetuate locating the position of the corner:

FOUND 4" x 36" CONCRETE MONUMENT WITH 1/2" IRON ROD, WITNESSED BY:

- SET NAIL AND TAG #28414 NORTH SIDE TELEPHONE POLE, N 89° E 73.53 FEET
- TOP CENTER OF GENERAL TELEPHONE CABLE BOX, S 51° E 39.80 FEET
- SET "P.K." NAIL TOP CENTER OF CONCRETE CORNER POST, S 53° W 38.13 FEET
- SET NAIL AND TAG #28414 SOUTH SIDE TELEPHONE POLE, N 61° W 43.38 FEET

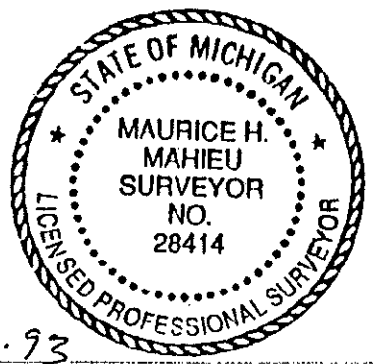

Signed by Maurice H. Mahieu Date 10.28.93
 Surveyor's Michigan License No. 28414

4. CORNER IDENTIFIED AS "IRON, STONE AND BRICK" BY INGHAM COUNTY ROAD COMMISSION ON THE JANUARY 1, 1969 MAP. WITNESSED BY: ROAD SIGN EAST 21.3'
ANCHOR POST NW 39.0'
6" ELM NW 41.5'
ANCHOR POST SW 37.8'
5. CORNER WAS RECORDED BY R.M. LESTER (P.S. #18998) IN L.C.R.C. LIBER 5, PAGE 121 AS PART OF THE 1978-79 INGHAM COUNTY SURVEY AND REMONUMENTATION PROJECT. THE L.C.R.C. NOTED THE FOLLOWING UNDER SECTION B:
- EXCAVATED A HOLE 6' x 5.8' TO AN AVERAGE DEPTH OF 3.5' AT THE INTERSECTION OF THE CENTERLINE OF FROST ROAD AND WILLIAMSTON ROAD. FOUND 8" BOAT SPIKE AT ROAD SURFACE ON THE INTERSECTION OF THE CENTERLINE OF FROST ROAD AND WILLIAMSTON ROAD. FOUND A 1/2" x 0.8" REROD BESIDE AND BELOW FOUND BOAT SPIKE. FOUND 1" BAR ENCIRCLED BY RED BRICK, 2.2' BELOW SURFACE AND BELOW 1/2" REROD. FOUND LARGE STONE (1.2' x 0.8') SURROUNDED AND SUPPORTED BY TILE AS CORNER DESCRIBED BY INGHAM COUNTY ROAD COMMISSION RECORDS. SET 4" x 36" CONCRETE MONUMENT WITH 1/2" x 38" REROD AND CAP #18998, WITH CONCRETE COLLAR AND COVER AT THE LOCATION OF LARGE STONE DESCRIBED ABOVE:
- SOUTH SIDE, CONCRETE CORNER POST, 2' FROM TOP S.W. 38.01'
EAST SIDE, CONCRETE CORNER POST, 2' FROM TOP NNW 308.90'
NAIL AND TAG #18998 NORTH SIDE TELEPHONE POLE EAST 73.50'
NAIL AND TAG #18998, SOUTH SIDE 40" MAPLE WEST 676.50'
6. CORNER WAS REFERRED ON A ACT 132 SURVEY BY DOUGLAS K. RICHARDSON (P.S. #31603) IN LIBER 5, PAGE 307. THE ONLY REFERENCE WAS BY THE LIBER AND PAGE OF A-5, ABOVE. SURVEY WAS RECORDED JANUARY 7, 1987.