

SURVEY & REMONUMENTATION

DEC 17 1999

SECTION

LAND CORNER RECORDATION CERTIFICATE
Filing Requirement of Act 74, Mich. P.A. 1970

For corners in ALAIEDON TOWNSHIP

INGHAM COUNTY Located In: Corner Code #

- 1. Public Land Survey T 3N R 1W E-2
2. Property Controlling in Section S T R
3. Miscellaneous Property in Sec. S T R

Paula Johnson
INGHAM COUNTY
REGISTER OF DEEDS
WOLVERINE ENGINEERS AND SUR

RECORDED CRNR 11.00

L-9 P-523

1999-054730



1999-054730

Page: 1 of 2

10/29/1999 09:34A

Register of Deeds Stamp & File Number

4. Lot No. , Recorded Plat
5. Private Claims

I, Maurice H. Mahieu, in a field survey on September 9, 1999 do hereby state that under requirements of P.A. 74, Michigan P.A. of 1970, the corner points mentioned in lines 1 and 2 above were in conformance with regulations and rules therefore as required in the current manual of survey instructions of the United States Department of the Interior, Bureau of Land Management or by a decree of a Court of Law and /or that the corner points mentioned in lines 3, 4 and 5 above were in conformance with the rules of the Michigan Board of Land Surveyors or by a Decree of a Court of Law; established, re-established, monumented, recovered, found as expressed below:

NOTE: Not more than 2 corners, all in the same town and range, may be recorded on this certificate.

A. Description of original monument and accessories and/or subsequent restoration:

- 1. Original corner set by Joseph Wampler D.S. on December 19, 1826 at a distance of 40.00 chains from E-3. " Set 1/4 sec. post fw. W. Ash 14 S 39° E 25. Beech 10 N 43° W 15.
2. County Surveyor's records Book 2, Page 177 contains a survey by A.P. Drake, County Surveyor, on October 13, 14, and 15, 1879 in which he found a post and an iron at the corner with the following witnesses: "Sugar 4 S 51 3/4° E 17. Sugar 4 S 44 1/4° W 11 1/4."
3. A L.C.R.C. recorded in Liber 5, Page 217 by Ronnie M. Lester P.S. #18998 on April 4, 1979 indicates he "Set 1/2" bar and cap in centerline of a Triple Willow that is located at the intersection of fences North, East, and West. Vintage property owner verified location as being used as corner for years. Measured North 2310.92' in close accord with GLO distance (2304.72')." Witnesses: Nail and Tag in E. side 8" Maple NW 43.82'. Nail and Tag S. side 6" Maple ESE 19.70'. Nail and Tag W. side 12" Willow S. 1.70'. Nail and Tag in 12" Maple SW 67.05'.

(Continued on Back)

B. Description of corner evidence found and/or method applied in restoring or reestablishing corner:


Found 1/2" iron #18998 in Triple Willow at N-E-W fence intersection. Found witnesses: Nail and Tag #18998 E. side Westerly trunk of Triple Willow S 10° W 1.13'. Nail and Tag #25832 S. side 10" Maple S 85° E 19.75'. Nail and Tag #25832 E. side 14" Maple N 45° W 43.80'. Accepted location of 1/2" iron as the corner because of long-standing occupation and close accordance with GLO records. Replaced 1/2" iron with a 3/4" x 24" iron form pin and 2 1/2" diameter aluminum P.A. 345 cap #28414.

C. Description of monument for corner and accessories established to perpetuate locating the position of the corner:

Replaced 1/2" iron with a 3/4" x 24" iron form pin and 2 1/2" aluminum P.A. 345 cap #28414 and witnessed: Found Nail and Tag #18998 E. side W'ly Trunk Triple Willow S 10° W 1.13'. Found Nail and Tag #25832 S. side 10" Maple S 85° E 19.75'. Found Nail and Tag #25832 E. side 14" Maple N 45° W 43.80'. Set Nail and Tag #28414 N. side 30" Cherry S 70° W 19.81'.

Signed by [Signature]

Date 10-13-99

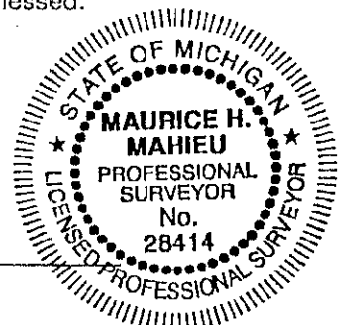

Surveyor's Michigan License No. 28414

E-2 T3N, R1W



1999-054730
Page: 2 of 2
10/29/1999 09:34A

(A. CONTINUED)

4. An Act 132 survey recorded in Liber 3, Page 838 by Ronnie M. Lester .P.S. #18998 on May 2, 1979 shows same monumentation and witnesses as in A.3. above. Corner measures 2311.12' from E-1.
5. An Act 132 survey recorded in Liber 3, Page 841 by Ronnie M. Lester P.S. #18998 on May 2, 1979 shows same monumentation, witnesses, and measurement to E-1 as in A.4. above.
6. The Woodlands Condominium Survey Plan recorded in Liber 1833, Page 342 by Walter K. Kyes, P.E. #14913 on June 25, 1990 shows corner measured 2310.86' from E-1. Monumentation and witnesses not given.

SURVEY &
REMONUMENTATION

DEC 09 1999

SECTION