

NOV 15 1994

COMMISSION

LAND CORNER RECORDATION CERTIFICATE
Filing Requirement of Act 74, Mich. P.A. 1970

JUL 6 8 14 AM '94

REGISTER OF DEEDS
INGHAM COUNTY, MICH.

For corners in

INGHAM

(County)

ALAIEDON TOWNSHIP

	Located In:	Corner Code #
1. Public Land Survey	T 3N R 1W	G-9
	T _____ R _____	_____
	T _____ R _____	_____
	T _____ R _____	_____
2. Property Controlling in Section	S _____ T _____ R _____	_____
	S _____ T _____ R _____	_____
3. Miscellaneous Property in Sec.	S _____ T _____ R _____	_____
	S _____ T _____ R _____	_____

Register of Deeds Stamp & File Number

4. Lot No. _____, Recorded Plat _____
5. Private Claims _____

	A	B	C	D	E	F	G	H	I	J	K	L	I
2	6	5	4	3	2								
3													
4	7	8	9	10	11	12							
5													
6	16	17	18	15	14	13							
7													
8	19	20	21	22	23	24							
9													
10	30	29	28	27	26	25							
11													
12	31	32	33	34	35	36							
13													

I, DAVID R. LOHR, in a field survey on MAY 18, 19 94, do hereby certify that under requirements of P.A. 74, Michigan P.A. of 1970, the corner points mentioned in lines 1 and 2 above were in conformance with regulations and rules therefore as required in the current manual of survey instructions of the United States Department of the Interior, Bureau of Land Management or by a decree of a Court of Law and/or that the corner points mentioned in lines 3, 4 and 5 above were in conformance with the rules of the Michigan Board of Land Surveyors or by a Decree of a Court of Law; established, re-established, monumented, re-monumented, recovered, found as expressed below:

NOTE: Not more than 4 corners, all in the same town and range, may be recorded on this certificate.

A. Description of original monument and accessories and/or subsequent restoration:

G-9 1. POST SET BY MUSGROVE EVANS IN DECEMBER 1826, WITNESSED BY:
BEECH 11" NORTH 47 1/2 DEGREES EAST, 16 LINKS. (10.56')
SUGAR 24" NORTH 82 DEGREES WEST, 17 LINKS. (11.22')
"MARGINAL NOTE"-OAK 11" NORTH 23 DEG. EAST, 61 1/2 LINKS. (40.59')

2. T.J. BROWN, COUNTY SURVEYOR IN AN UNRECORDED SURVEY, DATED 1873, FOLDER 1, PAGE 50, NO MENTION OF MONUMENT, " WITNESSED BY:
SWP. OAK 11" NORTH 23 DEGREES EAST, 61 1/2 LKS. (40.59')

CONTINUED ON BACK

B. Description of corner evidence found and/or method applied in restoring or reestablishing corner:

G-9: FOUND 1/2" IRON 1.0 FEET NORTH CENTERLINE LAMB ROAD ON PLOW LINE NORTH-SOUTH. WOOD ANCHOR POST ON LINE TO SOUTH. NO MONUMENT BOX. SAWCUT 1.5' X 1.5' HOLE THRU 2-1/2" BIT. AROUND 1/2" IRON, FOUND IRON TO BE 24" LONG, ALSO FOUND 8" BOATSPIKE UNDER IRON, EXCAVATED THRU 14" GRAVEL AND 6" TOPSOIL TO BLUE CLAY. EXCAVATED TO DEPTH OF 36" WITH 4" AUGER, FOUND NOTHING. ENLARGED HOLE AND DISCOVERED LARGE STONE 1.0' NORTH X 0.5' EAST OF IRON. ENLARGED SAWCUT AND FOUND STONE TO BE TRIANGULAR IN SHAPE ABOUT 16" LONG, WITH TOP ONLY 5-1/2" BELOW SURFACE OF ROADWAY. ACCEPTED STONE AS THAT SET BY DRAKE IN 1877, AS DISTANCE MATCHES TO G-10. STONE TOO SHALLOW TO INSTALL MON. BOX OVER TOP. REMOVED STONE AND SET 3/4" X 24" STANDARD REMON. BAR AND P.A. 345 CAP #30090. REMOVED PREVIOUS 1/2" IRON AND SET MON. BOX OVER STANDARD BAR.

C. Description of monument for corner and accessories established to perpetuate locating the position of the corner:

G-9: SET 3/4" X 24" STANDARD REMON. BAR/P.A. 345 CAP #30090 IN MON. BOX. WITNESSED BY:
SET CAP #30090 IN 3/4" HOLE IN WEST END OF 12" CMP AZ. 13 DEG. 15.05'
SET CAP #30090 IN 3/4" HOLE IN EAST END OF 12" CMP AZ. 62 DEG. 30.67'
SET NAIL/TAG #30090 W/S WOOD POST AZ. 183 DEG. 33.53'
SET NAIL/TAG #30090 W/S P. POLE AZ. 179 DEG. 128.52'
FD. NAIL/TAG #28532 N/S P. POLE AZ. 264 DEG. 326.09'
BEARING AND DISTANCE TO H-9 AZ. 90-45-47 2702.50'
BEARING AND DISTANCE TO G-10 AZ. 180-00-00 2656.42'

Signed by


David R. Lohr

Date JUNE 28, 1994

Surveyor's Michigan License No. 30090

P.A. 345 INGHAM COUNTY
DEED APPROVED 6/8/94 ML

FORM APPROVED BY MICHIGAN STATE BOARD OF LAND SURVEYORS, JAN. 1981
REVISED MAY 14, 1991

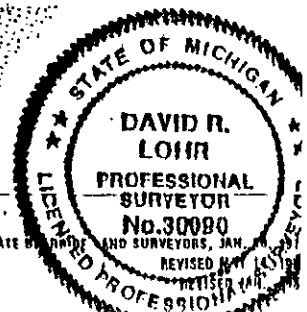

Page 2

3. E.A. CALKINS, COUNTY SURVEYOR IN AN UNRECORDED SURVEY, DATED 2/20/01, FOLDER 1, PAGE 1, NO MENTION OF MONUMENT, " WITNESSED BY:
SWP. OAK 11" NORTH 23 DEGREES EAST, 61 1/2 LKS. (40.59')
4. A.P. DRAKE, COUNTY SURVEYOR IN A SURVEY DATED 1877, VOLUME 3, PAGE 25, REFERS TO A "STONE," WITNESSED BY:
ELM 14" NORTH 39 1/2 DEGREES WEST, 116 1/2 LINKS.
5. A.P. DRAKE IN SURVEY DATED MAY 7, 1877, VOLUME 3, PAGE 132, COUNTY SURVEYORS RECORDS, REFERS TO "STONE", WITNESSED BY:
14" ELM, NORTH 39 1/2 DEGREES WEST, 116-1/2 LINKS (76.89')
SHOWS DISTANCE TO G-10 OF 40.250 CH. (2656.5')
SHOWS DISTANCE TO H-9 OF 40.750 CH. (2689.5')
6. NO OTHER REFERENCES FOUND IN COUNTY SURVEYORS RECORDS
7. INGHAM COUNTY ROAD COMMISSION GRID MAP (NO DATE) SHOWS "STONE"
WITNESSED BY: 12" ELM, SOUTH 65.0'
ANCHOR POST SOUTH 28.0'
ANCHOR POST NORTH 31.0'
8. L.C.R.C BY AUSTIN WILLIAMS, PS #21275, DATED 2/28/78, LIBER 4 PAGE 158, STATES, "FOUND IRON IN CENTERLINE OF LAMB ROAD AND IN LINE WITH POSSESSION LINE TO SOUTH", WITNESSED BY:
NAIL/TAG IN ANCHOR POST NORTH 32.57'
CENTERLINE OF 2" STEEL POST, NORTH 45 DEGREES WEST, 28.00'
NAIL/TAG IN POWER POLE SOUTH 86 DEGREES WEST, 325.95'
9. RECORDED SURVEY BY AUSTIN WILLIAMS, DATED 3/1/78, L.3-PG.258, NO MENTION OF MONUMENT. WITNESSED BY:
NAIL/ TAG IN ANCHOR POST, SOUTH 32.57'
CENTERLINE OF 2" STEEL POST NORTH 45 DEGREES WEST, 28.00'
NAIL/TAG IN POWER POLE SOUTH 86 DEGREES WEST, 325.95'
10. RECORDED SURVEY BY LARRY BRYAN, PS #25832, DATED, 2/28/90, LIBER 6, PAGE 48. STATES, "FOUND 1/2" BAR AND CAP IN CENTERLINE OF LAMB ROAD." WITNESSED BY:
FOUND NAIL AND TAG IN W/S ANCH. POST SOUTH 32.51'
FOUND NAIL AND TAG IN N/S POWER POLE S 80 DEG. W 325.70'
CENTERLINE OF 2" ST. POST N 40 DEG. W, 23.00'