

**SURVEY &  
REMONUMENTATION**

**JAN 18 2001**

**SECTION**

**LAND CORNER RECORDATION CERTIFICATE  
Filing Requirement of Act 74, Mich. P.A. 1970**

For corners in ALAIEDON TOWNSHIP

INGHAM COUNTY

Located In:

Corner Code #

- 1. Public Land Survey      T 3N R 1W  
                                   T     R      
                                   T     R      
                                   T     R
- 2. Property Controlling    S     T     R      
    in Section                S     T     R
- 3. Miscellaneous            S     T     R      
    Property in Sec.        S     T     R

I-2

Paula Johnson  
INGHAM COUNTY  
REGISTER OF DEEDS  
WOLVERINE ENGINEERS & SURVE

**L-10 P-20**

RECORDED CRNR 11.00

2000-046387



2000-046387

Page: 1 of 2

10/31/2000 01:29P

Register of Deeds Stamp & File Number

- 4. Lot No. \_\_\_\_\_, Recorded Plat \_\_\_\_\_
- 5. Private Claims \_\_\_\_\_

I, Maurice H. Mahieu, in a field survey on July 20, 2000, do hereby state that under requirements of P.A. 74, Michigan P.A. of 1970, the corner points mentioned in lines 1 and 2 above were in conformance with regulations and rules therefore as required in the current manual of survey instructions of the United States Department of the Interior, Bureau of Land Management or by a decree of a Court of Law and /or that the corner points mentioned in lines 3, 4 and 5 above were in conformance with the rules of the Michigan Board of Land Surveyors or by a Decree of a Court of Law; established, re-established, monumented, recovered, found as expressed below:

NOTE: Not more than 2 corners, all in the same town and range, may be recorded on this certificate.

	A	B	C	D	E	F	G	H	I	J	K	L	M
1													
2	6			5			4		3		2		1
3													
4	7			8			9		10		11		12
5													
6	18			17			16		15		14		13
7													
8	19			20			21		22		23		24
9													
10	30			29			28		27		26		25
11													
12	31			32			33		34		35		36
13													

A. Description of original monument and accessories and/or subsequent restoration:

- 1. Original corner set by J. Wampler D.S. on December 16, 1826 at a distance of 40.00 chains (2640.00') from I-3. "Set 1/4 post fw. Beech 12 N 89 E 18, Beech 9 N 83 1/2 W 15."
- 2. A L.C.R.C. recorded in Liber 2, Page 607 by Ronnie M. Lester R.L.S. #18998 on January 3, 1974 indicates, "Original Monument and Accessories obliterated."
- 3. Set 1/2" bar in meridian of expressway per M.D.S.H. Records and Witnesses of corner as established per pre-construction survey." Witnesses: Set P.K. Nail in asphalt shoulder 1' South from Concrete of Westbound I-96, NE 40.40'; Set P.K. Nail in asphalt shoulder 1' South from Concrete of West bound I-96, NW 36.31'; Set P.K. Nail in asphalt shoulder 1' South from Concrete of East bound I-96, South 32.31'.
- 4. An Act 132 survey recorded in Liber 1, Page 1079 by Ronnie M. Lester R.L.S. #18998 on January 3, 1974 shows corner measured 2559.97' from I-1. Monumentation not described. Witnesses same as in A-2.

(Continued On Back)

B. Description of corner evidence found and/or method applied in restoring or reestablishing corner:


Found a 1 3/4" pipe in the I-96 median just East of Rest Area. Found witnesses: P.K. Nail in asphalt South 32.29'. P.K. Nail in asphalt N 37° E 40.40'. P.K. Nail in asphalt N 11° W 36.25'. I-96 construction made excavation not necessary. Accepted position of 1 3/4" pipe as established by Surveyor Lester in Liber 2, Page 607 of Land Corners (A-2) as best perpetuated location for the corner. Affixed a 2 1/2" diameter aluminum cap stamped P.A. 345, Ingham County, #28414 to the 1 3/4" pipe.

C. Description of monument for corner and accessories established to perpetuate locating the position of the corner:

A 1 3/4" pipe with a 2 1/2" diameter Aluminum Cap stamped P.A. 345, Ingham County, #28414 in the I-96 median, witnessed by:  
 Found P.K. Nail in Asphalt South 32.29'  
 Found P.K. Nail in Asphalt N 37° E 40.40'  
 Found P.K. Nail in Asphalt N 11° W 36.25'  
 Set P.K. Nail in Asphalt S 52° W 49.03'

Signed by Maurice H. Mahieu  
 Surveyor's Michigan License No. 28414

Date 10-25-00

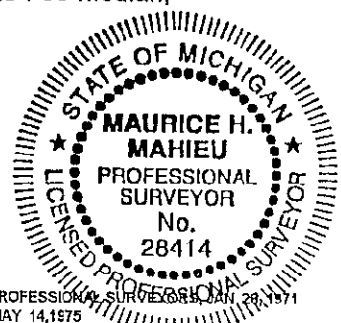

(A - Continued)

5. An Act 132 survey recorded in Liber 3, Page 914 by Larry A. Bryan L.S. #25832 on June 26, 1979 describes corner as a Found 2" pipe measuring 2642.92' from I-3 and 2643.51' from J-2. Witnesses: South 35.00' to North edge of East bound I-96.; North 35.30' to South edge of West bound I-96; Set spike at North edge of Concrete S 30° E 43.00'; Set spike at South edge of Concrete N 30° E 43.41'.
6. An Act 132 survey recorded in Liber 3, Page 1260 by Ronnie M. Lester R.L.S. #18998 on April 8, 1980 describes corner as a Found 1/2" pipe with the same measurement to I-3 and same witnesses as in A-4.
7. An Act 132 survey recorded in Liber 4, Page 800 by Austin C. Williams R.L.S. #21275 on December 13, 1983 does not describe monumentation nor contain relevant measurements. Witnesses same as in A-4 except the last one.
8. An Act 132 survey recorded in Liber 4, Page 937 by George M. Young L.S. #17640 on November 9, 1984 shows he used the corner. Monumentation, witnesses, and measurements not given.



2000-046387  
Page: 2 of 2  
10/31/2000 01:29P

**SURVEY &  
REMONUMENTATION**

**JAN 18 2001**

**SECTION**