

DEC 12 1997

COMMISSION

LAND CORNER RECORDATION CERTIFICATE
Filing Requirement of Act 74, Mich. P.A. 1970

Liber 9 Page 178

For corners in

INGHAM Located In: Corner Code #
(County) ALAIEDON TOWNSHIP

1. Public Land Survey T3N R1W K-4
T R
T R
T R

2. Property Controlling S T R
in Section S T R

3. Miscellaneous S T R
Property in Sec. S T R

FILED

970022435
06/20/1997 15:33:37
REGISTER OF DEEDS
Paula Johnson
INGHAM COUNTY, MI

4. Lot No. _____, Recorded Plat _____
5. Private Claims _____

Register of Deeds Stamp & File Number

	A	B	C	D	E	F	G	H	I	J	K	L
1												
2	6		5		4		3		2		1	
3												
4	7		8		9		10		11		12	
5												
6	18		17		16		15		14		13	
7												
8	19		20		21		22		23		24	
9												
10	30		29		28		27		26		25	
11												
12	31		32		33		34		35		36	
13												

I, RON HELSEL, in a field survey on APRIL 29, 19 97 do hereby certify that under requirements of P.A. 74, Michigan P.A. of 1970, the corner points mentioned in lines 1 and 2 above were in conformance with regulations and rules therefore as required in the current manual of survey instructions of the United States Department of the Interior, Bureau of Land Management or by a decree of a Court of Law and /or that the corner points mentioned in lines 3, 4 and 5 above were in conformance with the rules of the Michigan Board of Land Surveyors or by a Decree of a Court of Law; established, re-established, monumented, re-monumented, recovered, found as expressed below:

NOTE: Not more than 4 corners, all in the same town and range, may be recorded on this certificate.

A. Description of original monument and accessories and/or subsequent restoration:

ORIGINAL MONUMENT: POST SET BY MUSGROVE EVANS, U.S. DEPUTY SURVEYOR, DEC. 1826. BEECH 12", S57E, 4 LINKS; BEECH 6", N85W, 16 LINKS.

1) VOL. 2, PAGE 153, DATED JAN. 10-11, 1878 AND VOL. 2, PAGE 154, DATED JUNE 5-6, 1877, COUNTY SURVEYOR A.P. DRAKE, WITNESSED THE CORNER AS A POST: SUGAR 6", S70 1/2E, 85 LINKS
SUGAR 4", S20 1/2E, 38 LINKS


2) CORNER RECORDED IN L.C.R.C LIBER 5, PAGE 224, FIELD DATED DEC. 12, 1978, BY R. LESTER, NO. 18998 UNDER THE INGHAM COUNTY CETA PROGRAM OF THE LATE 1970'S. (CONTINUED ON BACK)

B. Description of corner evidence found and/or method applied in restoring or reestablishing corner:

FOUND 1/2" REROD AND CAP NO. 18998 ENCASED IN A 4" CONCRETE MONUMENT IN A CONCRETE COLLAR 4 FEET MORE LESS EAST OF THE C/L OF EVERY ROAD. LOCATED IN A ROAD BERM WITH 6 FOOT ROAD DITCH AND DRAINS ON THE EAST AND WEST SIDE OF THE ROAD. ACCEPTED THE CONCRETE MARKER AS THE BEST AVAILABLE EVIDENCE FOR A LOST CORNER AS STATED IN 2-A ABOVE.

C. Description of monument for corner and accessories established to perpetuate locating the position of the corner:
CONCRETE MONUMENT AND CAP NO. 18998

FOUND NAIL AND TAG NO. 39100, NORTH SIDE POWER POLE, AZ., 104 DEG., 480.01 FEET
FOUND DENT ON TOP OF WEST END OF 12" C.M.P., AZ., 168 DEG., 74.03 FEET
SET NAIL AND TAG NO. 18994 WEST/SIDE OF 50" OAK, AZ., 178 DEG., 512.37 FEET
SET NAIL AND TAG NO. 18994 WEST/SIDE OF POWER POLE, AZ., 173 DEG., 354.62 FEET
SET NAIL AND TAG NO. 18994 WEST/SIDE OF POWER POLE, AZ., 17 DEG., 275.03 FEET

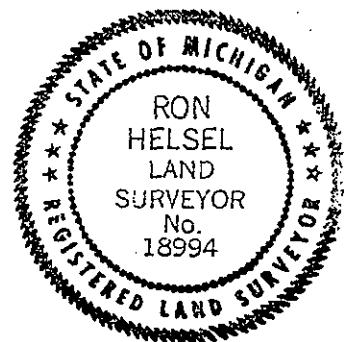

Signed by Ron Helsel Date 6-7-97
Surveyor's Michigan License No. 18994

A (CONTINUED)

2) * EXCAVATED A 6.3' X 7.5' HOLE TO AN AVERAGE DEPTH OF 2.7' ON THE C/L OF EVERY ROAD. FOUND NO EVIDENCE TO RE-ESTABLISH CORNER. CORNER CONSIDERED TO BE LOST. RE-ESTABLISHED CORNER MIDWAY AND ON LINE BETWEEN NORTHEAST CORNER (K-3. L.2, P.503) AND SOUTHEAST CORNER (K-5, L.3, P. 181) OF SECTION 11, + 4' EAST OF THE C/L OF EVERY ROAD.

SET 4" X 36" CONCRETE MONUMENT WITH 1'2" X 38" REROD AND CAP # 18998, AND CONCRETE COLLAR WITH CAP IN LOCATION RE-ESTABLISHED CORNER DESCRIBED ABOVE.

NAIL & TAG, #18998, NORTH SIDE POWER POLE, EAST, 48.04' (FOUND POWER POLE)

NAIL & TAG, #18998, NORTHWEST SIDE 48" OAK, SSE, 511.8' (FOUND OAK TREE)

DENT ON TOP CENTERLINE 12" C.M.P., SE, 74.03' (FOUND)

3) A SURVEY RECORDED IN LIBER 6, PAGES 50-51, DATED JAN. 2, 1990 BY L. BRYAN NO. 25832 CALLED FOR THE CONC. MON. WITH A BAR IN A CONCRETE COLLAR 3' EAST OF THE C/L OF EVERY ROAD.

SET NAIL AND TAG SOUTH SIDE GUARD POST, N85E, 10.90' (GONE)

SET NAIL AND TAG WEST SIDE GUARD POST, S20E, 57.86' (GONE)

SET NAIL AND TAG WEST SIDE GUARD POST, N20E, 92.74' (FOUND POST NAIL GONE)

4) A SURVEY RECORDED IN LIBER 7, PAGE 681-683, DATED NOV. 8, 1995 BY T. WEGMAN, NO. 39100 CALLED FOR A BENT 1/2" IRON ROD IN CONC. COLLAR + 3' E/CENTERLINE EVERY ROAD.

FND. N & T S. SIDE GUARD POST - N78E, 11.04' (REC. 10.90') (GONE)

FND. N & T E. SIDE GUARD POST - N12E, 60.37' (REC. 59.35') (GONE)

RESET N & T N. SIDE U.P., S82E, 60.37' (REC. 59.35') (FOUND)

FND. N & T NW SIDE 48" OAK, SSE, 511.8' (FOUND OAK TREE)


