

DEC 1 1997

COMMISSION

LAND CORNER RECORDATION CERTIFICATE
Filing Requirement of Act 74, Mich. P.A. 1970

Liber 9 Page 180

For corners in

INGHAM
(County)

Located In: ALAIEDON TOWNSHIP
Corner Code #

- 1. Public Land Survey T3N R 1W K-5
T R
T R
T R
- 2. Property Controlling in Section S T R
S T R
- 3. Miscellaneous Property in Sec. S T R
S T R

FILED

RECORDED
970022436
06/20/1997 15:33:38
REGISTER OF DEEDS
Paula Johnson
INGHAM COUNTY, MI

Register of Deeds Stamp & File Number

- 4. Lot No. _____, Recorded Plat _____
- 5. Private Claims _____

1	A	B	C	D	E	F	G	H	I	J	K	L
2		6		5		4		3		2		
3												
4		7		8		9		10		11		
5												
6		18		17		16		15		14		1
7												
8		19		20		21		22		23		2
9												
10		30		29		28		27		26		2
11												
12		31		32		33		34		35		3
13												

I, RON HELSEL, in a field survey on APRIL 29, 19 97 do hereby certify that under requirements of P.A. 74, Michigan P.A. of 1970, the corner points mentioned in lines 1 and 2 above were in conformance with regulations and rules therefore as required in the current manual of survey instructions of the United States Department of the Interior, Bureau of Land Management or by a decree of a Court of Law and /or that the corner points mentioned in lines 3, 4 and 5 above were in conformance with the rules of the Michigan Board of Land Surveyors or by a Decree of a Court of Law; established, re-established, monumented, re-monumented, recovered, found as expressed below:

NOTE: Not more that 4 corners, all in the same town and range, may be recorded on this certificate.


- A. Description of original monument and accessories and/or subsequent restoration:
ORIGINAL MONUMENT: POST SET BY MUSGROVE EVANS, U.S. DEPUTY SURVEYOR, DEC. 1826. IRONWOOD, 4", N65 1/2W, 11 LINKS HICKORY, 12", N35E, 20 LINKS.
1) VOL. 1, PAGE 62, COUNTY SURVEYOR, A. JACKSON, JULY 12, 1843 CALLED FOR SAME WITNESSES AS ORIGINAL CORNER.
2) VOL. 2, PAGE 152, 6-15, 1877 ;PAGE 153, JAN. 10 & 11, 1878; AND PAGE 154, JUNE 5 & 6, 1877, COUNTY SURVEYOR, A.P.DRAKE, CALLED FOR A STONE, WITNESSED AS NW COR. CHURCH WALL, S70 1/2E, 33 3/4 LINKS; SUGAR 3", N56E, 77 1/4 LINKS.
3) I. C. R. C. GRID MAP, REVISED 1969 CALLED FOR STONE IRON AND BRICK. CATALPA, 12", NNE, 110.15' IRON ANCH. POST, NV 30.6', IRON ANCH. POST, SE, 36.2', IRON ROAD SIGN, NE, 29.8' (ALL WITNESSES GONE 4/29/97).
4) A SURVEY WAS RECORD IN LIBER 1, PAGE 1272 ALONG WITH A L.C.R.C RECORDED IN LIBER 3, PAGE 181, DATED APRIL 11, 1974 BY R. HELSEL NO. 18994. "FOUND IRON, BRICK, AND STONE AS WITNESSED BY ICRC. USED ONE OF FOUR REMAINING WITNESSES. IRON ANCHOR POST NW 30.5' (GONE)
CENTERLINE ROAD SIGN S45W 38.25' (GONE)
N & C - N. SIDE POWER POLE S60E 85.65' (NEW POLE)

(CONTINUED ON BACK)

- B. Description of corner evidence found and/or method applied in restoring or reestablishing corner:
FOUND 5/8" REBAR IN MON. BOX 4.5 FEET NORTH OF C/L OF WILLOUGHBY ROAD AND 1 FOOT WEST C/L OF EVERY ROAD. EXCAVATED THROUGH MON. BOX AND FOUND POINTED STONE AND PIECES OF RED BRICK AS FOUND AND WITNESSED IN L.C.R.C. IN LIBER 3, PAGE 181. ACCEPTED THIS MARKER AS FAITHFUL PERPETUATION OF THE CORNER. REPLACED BAR WITH 3/4"x 24" FORM PIN AND CAP LABELED P.A. 345, P.S. NO. 18994.

- C. Description of monument for corner and accessories established to perpetuate locating the position of the corner:
3/4" FORM PIN AND MON. BOX 4.5 FEET NORTH OF CENTERLINE OF WILLOUGHBY ROAD.

FOUND NAIL AND TAG NO. 25832 SW/SIDE POWER POLE, AZ. 340 DEG., 59.54 FEET
FOUND NAIL AND TAG NO. 18994 NW/SIDE 20" ASH, AZ. 55 DEG., 60.07 FEET
SET NAIL AND TAG NO. 18994 NW/SIDE 8" WOOD POST BY PHONE RISER, AZ. 68 DEG., 38.80 FEET
CRIMP MARK IN TOP NORTH END OF 12" CMP, AZ. 209 DEG., 57.35 FEET
NORTHWESTERLY CORNER OF BRICK HOUSE FOUNDATION, AZ. 44 DEG., 145.79 FEET

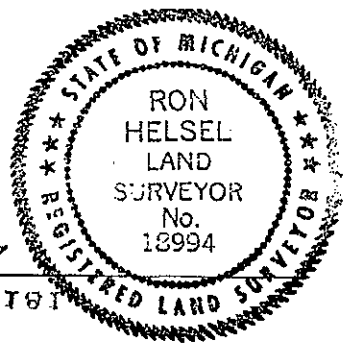

Signed by Ron Helsel Date 6-6-97

Surveyor's Michigan License No. 18994

P.A. 345 INGHAM COUNTY

A (CONTINUED)

- 5) A SURVEY WAS RECORDED IN LIBER 2, PAGE 1108 BY F. N. WHITE NO. 12034, APRIL 7, 1977 L.C.R.C. LIBER 3, PAGE 181 WAS CITE
- 6) A SURVEY WAS RECORDED IN LIBER 4, PAGE 1051 BY G. YOUNG NO. 17640, MARCH 7, 1985, L.C.R.C., LIBER 3, PAGE 182 WAS CIT
- 7) SURVEYS WERE RECORDED IN LIBER 6, PAGES 50-51, DATED JAN. 2, 1990 AND IN LIBER 6, PAGES 225-226, DATED FEB. 25, 1988 E
L. BRYAN NO. 25832, " FOUND 1/2" BAR 4' NORTH OF CENTERLINE OF WILLOUGHBY RD. 1' WEST OF THE CENTERLINE OF EVERY
ROAD." SIGN POST, S45W, 38.0'
 - FOUND NAIL AND CAP # 12034 IN NORTH SIDE POWER POLE, S75E, 85.65' (FOUND)
 - SET NAIL & TAG # 25832 IN WEST SIDE POWER POLE, N30W, 59.54' (FOUND)
 - SET NAIL & TAG # 25832 IN WEST SIDE 14" APPLE, N20E, 92.74' (GONE)
- 8) UNRECORDED SURVEY BY R. HELSEL, DATED MAR. 30, 1995, SURVEY NO. 95-6572 CALLED FOR A 5/8" REBAR IN A MON BOX, 5'
NORTH C/L ROAD. N & T N/SIDE P.POLE, S60E, 85.54' (FOUND)
 - N & T SE/SIDE U. POLE, N18W, 59.63' (FOUND)
 - N & T W/SIDE 18" ELM, N50E, 60.00' (CHINESE ELM)
 - NW'LY CORNER OF BRICK HOUSE, N45E, 145.79' (FOUND)

