

DEC 1 1997

COMMISSION

LAND CORNER RECORDATION CERTIFICATE
Filing Requirement of Act 74, Mich. P.A. 1970

Liber 9 Page 261

For corners in

INGHAM (County) Located In: ALAIEDON TOWNSHIP Corner Code #

1. Public Land Survey T 3N R 1W K-6
 T R
 T R
 T R

2. Property Controlling S T R
 in Section S T R

3. Miscellaneous S T R
 Property in Sec. S T R

FILED

970043435
10/31/1997 11:07:30
REGISTER OF DEEDS
Paula Johnson
INGHAM COUNTY, MI

Register of Deeds Stamp & File Number

4. Lot No. _____, Recorded Plat _____
5. Private Claims _____

I, RON HELSEL, in a field survey on JUNE 30, 1997
do hereby certify that under requirements of P.A. 74, Michigan P.A. of 1970, the corner points mentioned in lines 1 and 2 above were in conformance with regulations and rules therefore as required in the current manual of survey instructions of the United States Department of the Interior, Bureau of Land Management or by a decree of a Court of Law and /or that the corner points mentioned in lines 3, 4 and 5 above were in conformance with the rules of the Michigan Board of Land Surveyors or by a Decree of a Court of Law; established, re-established, monumented, re-monumented, recovered, found as expressed below:

	A	B	C	D	E	F	G	H	I	J	K	L
1												
2	6		5		4		3		2			
3												
4	7		8		9		10		11			
5												
6	18		17		16		15		14			
7												
8	19		20		21		22		23			24
9												
10	30		29		28		27		26			25
11												
12	31		32		33		34		35			36
13												

NOTE: Not more than 4 corners, all in the same town and range, may be recorded on this certificate.


A. Description of original monument and accessories and/or subsequent restoration:
ORIGINAL MONUMENT: POST SET BY MUSGROVE EVANS, U.S. DEPUTY SURVEYOR, MAR. 3, 1826. WITNESSED AS: HICKORY 9", S65E, 20 LINKS;
ELM, 24", N60W, 10 LINKS

- VOL. 1, PAGE 62, JULY 12, 1843, COUNTY SURVEYOR, A. JACKSON CITED THE ORIGINAL BEARING TREES.
- VOL. 2, PAGE 152, JUNE 15, 1879, COUNTY SURVEYOR, A. P. DRAKE CALLED FOR A STONE & WITNESSED "S W COR. OF S HOUSE, N29°40'E, 176 LINKS "
- THE INGHAM CO. ROAD COMM. GRID MAP CALLED FOR AN IRON SHAFT AND BRICK, SW COR. SCHOOL HOUSE , NE, 135.1'; (FOUND EXISTING RESIDENCE AT THIS LOCATION); 6" CATALPA, NE, 43.9'; ANCH. POST W, 26.0'.
- A L.C.R.C. WAS RECORDED IN LIBER 4, PAGE 55, FIELD DATED 4-7-1977, BY F. N. WHITE P.S. NO. 12034. "FOUND IRON 5' WEST CENTERLINE EVERY ROAD WITH P.K. NAIL PLACED OVER IT AT ROAD SURFACE." WITNESSED AS;
C/L STEEL ANCHOR POST , EAST, 23.33' (FOUND)
SOUTH END AND CENTER 12" CMP, S88°W, 18.80 FT. (FOUND)
NORTH END AND CENTER 12" CMP, N35°W, 29.08 FT. (FOUND)

(CONTINUED ON BACK)

B. Description of corner evidence found and/or method applied in restoring or reestablishing corner:
FOUND 1/2" IRON BAR 1 FOOT WEST OF C/L OF EVERY ROAD ON LINE WITH AN ANCIENT FENCE AND TREE LINE TO THE EAST. EXCAVATED 2.0 FEET DEEP AND FOUND A 1" AXLE SHAFT SURROUNDED WITH RED BRICK AT OLD CLAY ROAD BED AND DIRECTLY UNDER THE 1/2" BAR. IT APPEARS THAT AN ADDITION HAS BEEN ADDED TO THE OLD SCHOOL HOUSE WHICH EXPLAINS THE DIFFERENCE BETWEEN THE ICRC GRID MAP WITNESS AND DRAKES WITNESS. ACCEPTED THE POSITION OF THE AXLE SHAFT AS FAITHFUL PERPETUATION OF THE CORNER AND SET A 3/4" BY 24" FORM PIN AND CAP STAMPED P.A. 345, P.S. NO. 18994 TO GRADE OVER THE AXLE SHAFT IN A MONUMENT BOX.

C. Description of monument for corner and accessories established to perpetuate locating the position of the corner:
3/4" FORM PIN AND CAP IN MONUMENT BOX 1.0 FEET WEST OF C/L OF EVERY ROAD.
SOUTHWEST CORNER OF OLD SCHOOL HOUSE, AZ. 44°, 135.1 FEET
SET NAIL AND TAG NO. 18994, SE/SIDE 12" NORWAY MAPLE
FACE OF STEEL ANGLE IRON ANCHOR POST, EAST, 23.16 FEET
FILE NOTCH IN NORTH END OF 12" C.M.P., AZ. 330°, 29.06 FEET
FILE NOTCH IN SOUTH END OF 12" C.M.P., AZ. 275°, 18.37 FEET
FOUND NAIL & TAG NO. 25832, WEST/SIDE POWER POLE, AZ. 29°, 172.55 FEET
FOUND NAIL & CAP NO. 12034, NORTH/SIDE POWER POLE, AZ. 97°, 55.35 FEET

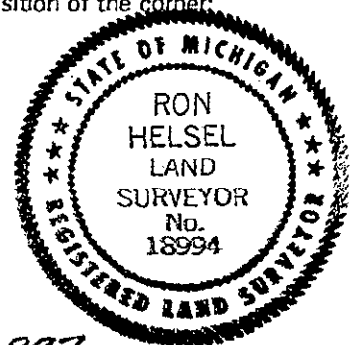

Signed by Ron Helsel
Surveyor's Michigan License No. 18994

Date Oct. 22, 1997

A. (CONTINUED)

- 5) A SURVEY WAS RECORDED IN LIBER 2, PAGE 1108 BY F. N. WHITE, WITNESSED SAME AS A-4 ABOVE.
- 6) A SURVEY WAS RECORDED IN LIBER 4, P. 1051 BY G. YOUNG, P.S. NO. 17640, DATED MAR. 7, 1985, LIBER AND PAGE IN 4-A WAS CITED.
- 7) A SURVEY WAS RECORDED IN LIBER 4, PAGES, 1211 AND 1212 BY R. LESTER, P.S. NO. 18998, DATED FEB., 1986. HE GAVE THE SAME WITNESSES AS 4-A ABOVE.
- 8) A SURVEY WAS RECORDED IN LIBER 6, PAGES, 625-626 BY L. BRYAN, P.S. NO. 25832, DATED 2-25-88. HE CALLED FOR A 3/4" BAR IN THE C/L OF EVERY ROAD.
STEEL ANCHOR POST, EAST, 23.3'
SOUTH END OF CORRUGATED METAL PIPE, S80°W, 18.8' (FOUND)
NORTH END OF CORRUGATED METAL PIPE, N30°W, 29.0' (FOUND)
FOUND NAIL AND TAG IN NORTH SIDE POWER POLE, EAST, 55.33' (FOUND)
SET NAIL & TAG #25832 IN WEST SIDE POWER POLE, N20°E, 172.56' (FOUND)



