

DEC 1 2 1997

COMMISSION

LAND CORNER RECORDATION CERTIFICATE
Filing Requirement of Act 74, Mich. P.A. 1970

Liber

9 Page 184

For corners in

INGHAM
(County)

Located in: Corner Code #
ALAIEDON TOWNSHIP

FILED

970022438
06/20/1997 15:33:42
REGISTER OF DEEDS
Paula Johnson
INGHAM COUNTY, MI

- 1. Public Land Survey T3N R1W L-5
T R
T R
T R
- 2. Property Controlling S T R
in Section S T R
- 3. Miscellaneous S T R
Property in Sec. S T R

Register of Deeds Stamp & File Num

- 4. Lot No. _____, Recorded Plat _____
- 5. Private Claims _____

I, RON HELSEL, in a field survey on MAY 30, 19 97 do hereby certify that under requirements of P.A. 74, Michigan P.A. of 1970, the corner points mentioned in lines 1 and 2 above were in conformance with regulations and rules therefore as required in the current manual of survey instructions of the United States Department of the Interior, Bureau of Land Management or by a decree of a Court of Law and /or that the corner points mentioned in lines 3, 4 and 5 above were in conformance with the rules of the Michigan Board of Land Surveyors or by a Decree of a Court of Law; established, re-established, monumented, re-monumented, recovered, found as expressed below:

	A	B	C	D	E	F	G	H	I	J	K
1											
2	6		5		4		3		2		
3											
4	7		8		9		10		11		1
5											
6	18		17		16		15		14		1
7											
8	19		20		21		22		23		2
9											
10	30		29		28		27		26		2
11											
12	31		32		33		34		35		3
13											

NOTE: Not more than 4 corners, all in the same town and range, may be recorded on this certificate.

A. Description of original monument and accessories and/or subsequent restoration:

ORIGINAL MONUMENT: POST SET BY MUSGROVE EVANS, U.S. DEPUTY SURVEYOR DEC., 1826
WITNESSED AS: BEECH 12", N44E, 13 LINKS
IRONWOOD 6", S10 1/2W, 20 LINKS

- 1) VOL. 1, PAGE 62, COUNTY SURVEYOR, A. JACKSON, JULY 12, 1843 CALLED FOR A POST WITH THE ORIGINAL WITNESSES.
- 2) VOL. 2, PAGE 153, COUNTY SURVEYOR, A.P. DRAKE, JAN. 10-11, 1878, CALLED FOR A STONE
WITNESSED AS: SUGAR 16", S1 3/4W, 39 LINKS
SUGAR 12", S51 1/2E, 65 LINKS
- 3) I.C.R.C. GRID MAP CALLED FOR A 1" X1" IRON CHERRY 14" N 30.9'; MAPLE 8" ESE 73.8'; ANCH POST S 29.6'
(CONTINUED ON BACK)


B. Description of corner evidence found and/or method applied in restoring or reestablishing corner:

FOUND 1" X 1" X 24" SQUARE IRON PIN WEDGED BETWEEN STONES IN MONUMENT BOX 2' NORTH CENTERLINE OF WILLOUGHBY ROAD AND 1.5 FEET EAST OF A FENCE LINE TO THE SOUTH. FOUND THE MAPLE AND THE ANCHOR POST AS WITNESSED BY I.C.R.C. ACCEPTED THE SQUARE IRON PIN AS A FAITHFUL PERPETUATION MARKER FOR THE CORNER. SET A 1/2 BAR AND CAP STAMPED P.S. NO. 18994 NEXT TO THE PIN TO CONFORM WITH PUBLIC ACT 345. THE SQUARE PIN IS THE MARKER.

C. Description of monument for corner and accessories established to perpetuate locating the position of the corner:

1" X 1" SQUARE IRON PIN IN MON. BOX

- FOUND 1/2" IRON BAR, SOUTH, 32.98 FEET
- FOUND NAIL AND TAG NO. 25832 ON WEST/SIDE OF UTILITY POLE, AZ. 15 DEG., 54.00 FEET
- FOUND 4" STEEL ANCHOR POST, AZ. 186 DEG. 29.18 FEET TO CENTER
- FOUND NAIL AND TAG NO. 18998 NE/SIDE OF 18" MAPLE, AZ. 121 DEG., 72.80 FEET
- SET NAIL AND TAG NO. 18994 ON WEST/SIDE OF 14" WALNUT, AZ. 196 DEG., 31.70 FEET

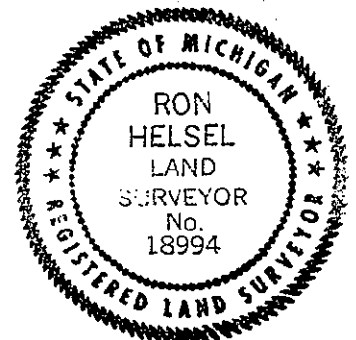

Signed by Ron Helsel Date 6-6-97
Surveyor's Michigan License No. 18994

A CONTINUED

4) A L.C.R.C. WAS RECORDED IN LIBER 3, PAGE 179, FIELD DATED APRIL 11, 1974 BY R. HELSEL NO. 18994 ALONG WITH A SURVEY RECORDED IN LIBER 1, PAGE 1272. "FOUND 1" X 1" IRON AND 2 OF 3 WITNESSES FROM ICRC RECORDS. IRON IN CLOSE ACCORD WITH G.O. NOTES AND EXISTING FENCES".

- N & C - SE SIDE 18" MAPLE S70E 73.17' (FOUND)
- N & C - W. SIDE 12" WALNUT S15W 31.67' (FOUND)
- C/L STEEL ANCHOR POST S 29.6' (FOUND)

5) SURVEYS WERE RECORDED IN LIBER 2, PAGES 939-943, DATED JULY 26, 1976, IN LIBER 2, PAGES 1050-1053, DATED NOV. 24, 1976, IN LIBER 3, PAGES 44-45, DATED APRIL 22, 1977, AND IN LIBER 3, PAGES 343-345, DATED MAY 5, 1978, BY R. LESTER NO. 18998. HE CALLED FOR THE SAME WITNESSES AS IN THE L.C.R.C. IN 4-A ABOVE.

6) A SURVEY WAS RECORDED IN LIBER 4, PAGE 1076, DATED JUNE 5, 1984 BY M. FOUTY, NO. 18989. WITNESSED SAME AS 4-A ABOVE.

7) A SURVEY WAS RECORDED IN LIBER 5, PAGES 411-412, DATED SEPT. 4, 1984, BY D. RICHARDSON NO. 31603. LIBER 3, PAGE 603 WAS CITED FOR CORNER, (WRONG PAGE NUMBER).

8) A SURVEY WAS RECORDED IN LIBER 6, PAGES 225-226, DATED FEB. 25, 1988, BY L. BRYAN NO. 25832. CALLED FOR 1" X 1" IRON WITH SAME WITNESSES AS 4-A ABOVE.

9) UNRECORDED SURVEY BY R. HELSEL, DATED MAR. 30, 1995, JOB NO. 95-6572, CALLED FOR A 1" X 1" BAR IN A MON. BOX

- N & T NE/SIDE 18" MAPLE, S70E, 72.80' (FOUND)
- N & T W/SIDE 14" WALNUT, S15W, 31.70' (FOUND)
- C/L STEEL POST, SOUTH, 29.18' (FOUND)
- N & T W/SIDE UTILITY POLE, 54.00' (FOUND)

 OFFICE OF THE SURVEYOR GENERAL
 12-18-95

LITED