

DEC 1 2 1997

COMMISSION

LAND CORNER RECORDATION CERTIFICATE

Filing Requirement of Act 74, Mich. P.A. 1970 Liber

9 Page 263

For corners in

INGHAM

(County)

Located In: ALAIEDON TOWNSHIP

Corner Code # L-6

- 1. Public Land Survey T 3N R 1W L-6
2. Property Controlling in Section S T R
3. Miscellaneous Property in Sec. S T R

FILED

970043436
10/31/1997 11:07:32
REGISTER OF DEEDS
Paula Johnson
INGHAM COUNTY, MI

Register of Deeds Stamp & File Number

4. Lot No. Recorded Plat
5. Private Claims

1. RON HELSEL, in a field survey on JULY 7, 1997 do hereby certify that under requirements of P.A. 74, Michigan P.A. of 1970, the corner points mentioned in lines 1 and 2 above were in conformance with regulations and rules therefore as required in the current manual of survey instructions of the United States Department of the Interior, Bureau of Land Management or by a decree of a Court of Law and /or that the corner points mentioned in lines 3, 4 and 5 above were in conformance with the rules of the Michigan Board of Land Surveyors or by a Decree of a Court of Law; established, re-established, monumented, re-monumented, recovered, found as expressed below:

Grid table with columns A-L and rows 1-13. Cell (6,13) is circled.

NOTE: Not more that 4 corners, all in the same town and range, may be recorded on this certificate.


A. Description of original monument and accessories and/or subsequent restoration: MONUMENT NOT SET IN ORIGINAL GOVERNMENT SURVEY. DID NOT FIND ANY PUBLIC RECORDS OF COUNTY SURVEYOR ACTIVITY FOR THIS CORNER.

- 1) A SURVEY WAS RECORDED IN LIBER 1, PAGE 1272, DATED APRIL 10, 1974, BY R. HELSEL, NO. 18994. SURVEY WAS TIED TO THE NORTH-SOUTH 1/4 LINE FROM L-5 TO L-7.
2) A SURVEY WAS RECORDED IN LIBER 4, PAGE 1076, DATED 6-5-84, BY M. FOUTY, NO. 18989. SURVEY WAS TIED TO THE NORTH-SOUTH 1/4 LINE FROM L-5 TO L-7.
3) A SURVEY WAS RECORDED IN LIBER 4, PAGES 1213-1214, DATED FEB. 13, 1986 BY R. LESTER, P.S. NO. 18998. SURVEYOR LESTER SET A 1/2" BAR AND CAP, AT THE INTERSECTION OF THE 1/4 LINES ACCORDING TO HIS FIELD NOTES. NO WITNESSES WERE GIVEN.
4) A L.C.R.C. WAS RECORDED IN LIBER 7, PAGE 43, FIELD DATED FEB. 25, 1988 ALONG WITH A SURVEY RECORDED IN LIBER 6, PAGE 225-226 OF SAME DATE, BY L. BRYAN P.S. NO. 25832. HE FOUND A 1/2" BAR AND CAP NO. 18998, P.S. R. LESTER, 1 FOOT EAST AND 4.3 FEET SOUTH OF THE NORTH-SOUTH AND EAST-WEST INTERSECTION OF FENCES. "BAR AND CAP WAS FOUND TO BE AT THE INTERSECTION OF 1/4 LINES."

SET NAIL AND TAG #25832 IN SOUTH/SIDE 4" ELM, N85W, 9.92' (FOUND ELM)
SET NAIL AND TAG #25832 IN EAST SIDE 5" ELM, SOUTH, 15.81' (FOUND ELM)
SET NAIL AND TAG #25832 IN SOUTH/SIDE 8" MULTI-BOX ELDER, N80W, 26.64' (FOUND ELDER CLUMP)
B. Description of corner evidence found and/or method applied in restoring or reestablishing corner:
FOUND THE 1/2" BAR AND CAP NO. 18998 AS CALLED FOR BY L. BRYAN, 4.3 FEET, SOUTH AND 1.0 FEET EAST OF A 6" STEEL ANCHOR POST WITH FENCES RUNNING NORTH, SOUTH, AND EAST. FIELD SEPARATION LINE TO THE WEST. EXCAVATED AROUND THE STEEL POST AND FOUND A LARGE CIRCLE OF FIELD STONES BUT NO EVIDENCE OF A PREVIOUS CORNER OR ACCESSORIES. ACCEPTED THE POSITION OF THE 1/2" BAR AS A MARKER FOR THE CORNER AND LEFT IT IN POSITION. BRYAN SURVEY CALLED FOR MEASUREMENTS OF 2661.62 FEET TO THE WEST 1/4 CORNER AND 2651.61 FEET TO THE NORTH 1/4 CORNER. SURVEYOR LESTER'S FIELD NOTES CALLED FOR MEASUREMENTS OF 2661.50 FEET TO THE WEST 1/4 CORNER & 2651.56 FEET TO THE NORTH 1/4 CORNER.

C. Description of monument for corner and accessories established to perpetuate locating the position of the corner: 1/2" X 18" IRON BAR AND CAP, P.S. NO. 18998 4.3 FEET SOUTH AND 1.0 FEET EAST OF A 6" STEEL ANCHOR POST.

SET NAIL AND TAG NO. 18994 EAST/SIDE 12" ELM, AZ. 185 DEG., 16.00 FEET
SET NAIL AND TAG NO. 18994 EAST/SIDE 10" ELM, AZ. 305 DEG., 9.28 FEET
SET NAIL AND TAG NO. 18994 SOUTH/SIDE 8" BOX ELDER CLUMP, AZ. 90 DEG., 25.86 FEET
EAST/SIDE OF CENTERLINE OF 6" STEEL ANCHOR POST, NORTH, 4.3 FEET.

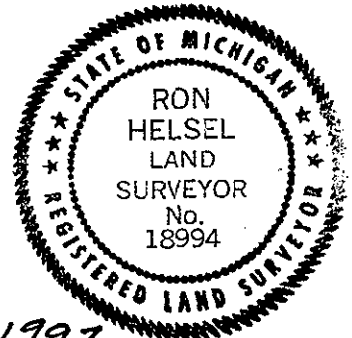

Signed by Ron Helsel Date Oct 22, 1997
Surveyor's Michigan License No. 18994