
## SURVEY & REMONUMENTATION

DEC 1 6 1996	I				
COMMISSIO		ECORDATION CERTIF	P4884	<b>9</b> Page	16
For corners in <u>Ingham</u> (County)  Alaredon Township		nt of Act 74, Mich. P.A Corner Code #	L. 1970	FILED	
Alaiedon Township  1. Public Land Survey	T <u>3N</u> R <u>I W</u> T R T R		R	960036935; /09/1996 15:10:00 EGISTER OF DEEDS Paula Johnson INGHPM COUNTY, MI	)
in Section S 3. Miscellaneous S	T R S T R S T R S T R		Register of D	Deeds Stamp & F	ile Numbe
4. Lot No, Reco			A B	C D E F G	H   J
I, David R. Lony, in a do hereby certify that under requirer in lines 1 and 2 above were in conformanual of survey instructions of Management or by a decree of a Co 5 above were in conformance with Decree of a Court of Law; establishes expressed below:  NOTE: Not more than 4 corners on this certificate.	ments of P.A. 74, Michigan P.A. of rmance with regulations and rules of the United States Department ourt of Law and/or that the corner the rules of the Michigan Board ed, re-established, monumented, restablished, all in the same town and range.	1970, the comer points mentitherefore as required in the culof the Interior, Bureau of points mentioned in lines 3, 4 of Professional Surveyors or re-monumented, recovered, fige, may be recorded	oned 6—18— Irrent 7— Land 7— I and 8—19— by a 9— ound 10—30— 11— 12—31— 13—————————————————————————	17 - 16 - 17 - 16 - 17 - 16 - 17 - 17 -	22 23 23 27 26 34 34 35 3
4-2 1. POST SET BY	JOS. WAMPLER, DEP 1: CHERRY 9" N 6 LYNN 10" S 3	. SURVEYOR, IN	DECEMBER 1 2 LINKS (4	.95')	
VOL "C", PAG	COUNTY SURVEYOR I GE 17. MAKES NO R ICE WEST TO L-2 OF CONTINUE	EFERENCE TO MON	NUMENT OR W		
B. Description of comer evide	nce found and/or method app	olied in restoring or reesta	ablishing corner:		
PK NAIL AND UNC INTERIOR OF MON AS PER LCRC OF CORNER AS PER I	PARENT LOCATION OF C NAIL 1.58' SOUTH COVERED MONUMENT B I. BOX AND FOUND 4 LIBER 5, PG. 371. TEM #7, AND RAISE ACE (COULD NOT RE	OF PIPE. EXCA OX UNDER 5" OF " CONCRETE MONU ACCEPTED 4" O D TO GRADE WITH	AVATED AT L PAVING. EX JMENT WITH CONCRETE MO H 3 RINGS.	OCATION OF CAVATED CAP @18998 NUMENT AS LEFT 1"	3,

C. Description of monument for corner and accessories established to perpetuate locating the position of the corner:

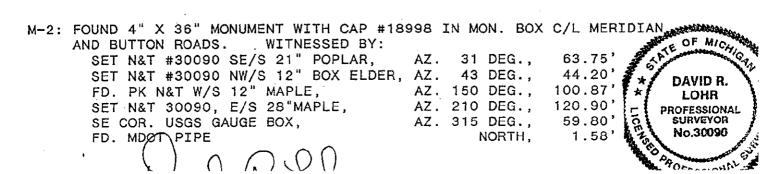

Liber 9 Page 17

M-2, ALAIEDON TOWNSHIP, PART A - CONTINUED

3 CODNED DEFEDENCED BY CONGINEDS DOWED CO "MSHD 33084-08" 1980 D H W "