

REMONUMENTATION

DEC 16 1996

COMMISSION

LAND CORNER RECORDATION CERTIFICATE

Liber 9 Page 6

Filing Requirement of Act 74, Mich. P.A. 1970

For corners in  
Ingham  
(County)

Located In:

Corner Code #

Alaiedon Township

**FILED**

RECORDED  
960038954  
10/09/1996 15:09:52  
REGISTER OF DEEDS  
Paula Johnson  
INGHAM COUNTY, MI

- |                                      |   |           |   |           |            |
|--------------------------------------|---|-----------|---|-----------|------------|
| 1. Public Land Survey                | T | <u>3N</u> | R | <u>1W</u> | <u>M-3</u> |
|                                      | T | _____     | R | _____     | _____      |
|                                      | T | _____     | R | _____     | _____      |
|                                      | T | _____     | R | _____     | _____      |
| 2. Property Controlling in Section   | S | _____     | T | _____     | _____      |
|                                      | S | _____     | T | _____     | _____      |
| 3. Miscellaneous Property in Section | S | _____     | T | _____     | _____      |
|                                      | S | _____     | T | _____     | _____      |

Register of Deeds Stamp & File Number

4. Lot No. \_\_\_\_\_, Recorded Plat \_\_\_\_\_  
5. Private Claims \_\_\_\_\_

	A	B	C	D	E	F	G	H	I	J	K
2	6		5		4		3		2		
3											
4	7		8		9		10		11		
5											
6	18		17		16		15		14		
7											
8	19		20		21		22		23		
9											
10	30		29		28		27		26		
11											
12	31		32		33		34		35		
13											

I, David R. Lohr, in a field survey on August 8, 1996, do hereby certify that under requirements of P.A. 74, Michigan P.A. of 1970, the corner points mentioned in lines 1 and 2 above were in conformance with regulations and rules therefore as required in the current manual of survey instructions of the United States Department of the Interior, Bureau of Land Management or by a decree of a Court of Law and/or that the corner points mentioned in lines 3, 4 and 5 above were in conformance with the rules of the Michigan Board of Professional Surveyors or by a Decree of a Court of Law; established, re-established, monumented, re-monumented, recovered, found as expressed below:

NOTE: Not more than 4 corners, all in the same town and range, may be recorded on this certificate.

A. Description of original monument and accessories and/or subsequent restoration:

- M-3 1. POST SET BY JOS. WAMPLER, DEP. SURVEYOR, IN DECEMBER 1826, WITNESSED BY: ELM 9" N 31 W 33 1/2 LINKS (22.11') BEECH 8" S 6 1/2 W 21 LINKS (13.86')
2. NO RECORD OF THIS CORNER FOUND IN COUNTY SURVEYOR'S RECORDS.  
CONTINUED ON BACK

B. Description of corner evidence found and/or method applied in restoring or reestablishing corner:

- M-3: SEARCHED AT APPARENT LOCATION OF CORNER AND FOUND 1/2" IRON IN HOLE IN INTERSECTION OF MERIDIAN AND STILLMAN ROADS. EXCAVATED 16" X 16" HOLE AROUND IRON AND FOUND IT TO BE THE 4" CONCRETE MONUMENT AS PER LCRC OF LIBER 5, PG 244. MONUMENT WAS ABOUT 5" BELOW GRADE. RAISED TO GRADE WITH 3 RINGS. FOUND 3 OF 4 WITNESSES OF ITEM #6, ACCEPTED 4" CONCRETE MONUMENT AS CORNER AS PER ITEM #6.

C. Description of monument for corner and accessories established to perpetuate locating the position of the corner:

- M-3: FOUND 4" X 36" MONUMENT WITH CAP #18998 IN MON. BOX C/L MERIDIAN AND STILLMAN ROADS. WITNESSED BY:
- |                            |    |          |        |
|----------------------------|----|----------|--------|
| SET N/T #30090 E/S P. POLE | AZ | 205 DEG. | 71.82' |
| SET N/T #30090 W/S P. POLE | AZ | 158 DEG. | 71.90' |
| SET N/T #30090 S/S 10" OAK | AZ | 115 DEG. | 45.44' |
| SET N/T #30090 NW/S 6' OAK | AZ | 53 DEG.  | 48.60' |




Signed by David R. Lohr  
Surveyor's Michigan License No. 30090

Date Sept 18, 1996

M-3, ALAIEDON TOWNSHIP, PART A - CONTINUED

3. CORNER REFERENCED BY CONSUMERS POWER CO., "MSHD 33084-06, 1960, D.H.W."  
 "SE CORNER, SECTION 1, FOUND STONES, 1" PIPE TO SURFACE.  
 WITNESSED BY: 23" MAPLE, N 15 E, 92.83'  
                   20" ELM, N 65 W, 63.16'  
                   15" OAK, N 85 E, 19.33'  
 WEST 1/4 POST, SECTION 7, T3N-R1E, SOUTH 1113.71'  
 NW CORNER, SECTION 7, T3N-R1E, NORTH 1525.52'
  
4. CORNER REFERENCED ON MDSH FORM 280 CARD NOT DATED, NOT SIGNED.  
 "COMMON TO 1, 12 - SE COR OF 1 - 1" IRON PIPE TO SURFACE - FOUND STONES.  
 WITNESSED BY: 23" MAPLE - N 15 E - 92.83'  
                   20" ELM - N 65 W - 63.16'  
                   15" OAK - N 85 E - 19.33'
  
5. INGHAM COUNTY ROAD COMM. GRID MAP DATED JAN. 1, 1969 SHOWS  
 "1" IRON PIPE, (MDSH). SAME WITNESSES AS ABOVE ITEM #4.
  
6. LCRC BY RONNIE LESTER, PS #18998, DATED 11/08/78, RECORDED IN LIBER 5,  
 PAGE 244, PART "B" STATES: "EXCAVATED A HOLE 10' X 10' TO AN AVERAGE  
 DEPTH OF 3', AT THE INTERSECTION OF THE CENTERLINES OF MERIDIAN AND  
 STILLMAN ROADS. FOUND 1" IRON PIPE 0.1' BELOW ROAD SURFACE AND +/- 1.0'  
 EAST OF THE CENTERLINE OF MERIDIAN ROAD AND ON CENTERLINE OF STILLMAN ROAD.  
 FOUND 10" BOLT SPIKE AT ROAD SURFACE, AT THE INTERSECTION OF THE  
 CENTERLINES OF MERIDIAN AND STILLMAN ROAD. FOUND 8" BOLT SPIKE DIRECTLY  
 BENEATH 10" BOLT SPIKE AND A LARGE STONE IN CLAY DIRECTLY BENEATH 8" BOLT  
 SPIKE. ACCEPTED 1" IRON PIPE AS CALLED FOR IN MDSHT FORM 280 AND RECORDS  
 OF ROAD COMMISSION AND CONSUMERS POWER. EXCAVATION CONDUCTED BY INGHAM  
 COUNTY SURVEY AND REMONUMENTATION PROJECT CREW."  
  
 PART "C" STATES: " SE CORNER, SECTION 1, T3N, R1W - SET 4" X 36"  
 CONCRETE MONUMENT WITH 1/2" X 38" REROD AND CAP #18998, AND CONCRETE  
 COLLAR AND CAP IN LOCATION OF IRON PIPE DESCRIBED ABOVE: WITNESSED BY:  
  
 NAIL & TAG, #18998, SOUTH SIDE 6" OAK, NE, 59.02' (GONE)  
 NAIL & TAG, #18998, WEST SIDE 36" OAK, SE, 139.69' (FD. TREE)  
 NAIL & TAG, #18998, SOUTHEAST SIDE POWER POLE, SW, 71.75' (FOUND)  
 NAIL & TAG, #18998, SOUTHWEST SIDE 6" OAK, ESE, 45.44' (FOUND)
  
7. RECORDED SURVEY BY FRED N. WHITE, LS #12034, DATED 9/09/82, RECORDED  
 IN LIBER 4, PAGE 689, REFERS TO CORNER AS "SW (SE) CORNER SECTION 1,  
 T3N, R1W, L5, PG. 244." NO MENTION OF MONUMENT OR WITNESSES.

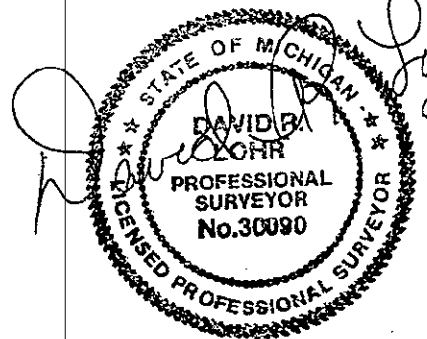

INGHAM COUNTY MI  
 15019 700200  
 REGISTER OF DEEDS  
 10/08/1988 12:03:25  
 #0003882#  
 RECORDED  
**FILED**