

our  
MEMORANDUM

DEC 1 2 1997

COMMISSION

LAND CORNER RECORDATION CERTIFICATE  
Filing Requirement of Act 74, Mich. P.A. 1970

Liber 9 Page 232

For corners in

<u>INGHAM</u> (County)	Located In:	Corner Code #
	<u>ALAIEDON TOWNSHIP</u>	
1. Public Land Survey	<u>T 3N R 1W</u>	<u>M-6</u>
	T _____ R _____	_____
	T _____ R _____	_____
	T _____ R _____	_____
2. Property Controlling in Section	S _____ T _____ R _____	_____
	S _____ T _____ R _____	_____
3. Miscellaneous Property in Sec.	S _____ T _____ R _____	_____
	S _____ T _____ R _____	_____

FILED

970041155  
10/20/1997 13:41:35  
REGISTER OF DEEDS  
Paula Johnson  
INGHAM COUNTY, MI

Register of Deeds Stamp & File Number

4. Lot No. \_\_\_\_\_, Recorded Plat \_\_\_\_\_  
5. Private Claims \_\_\_\_\_

I, RON HELSEL, in a field survey on JULY 5, 1997 do hereby certify that under requirements of P.A. 74, Michigan P.A. of 1970, the corner points mentioned in lines 1 and 2 above were in conformance with regulations and rules therefore as required in the current manual of survey instructions of the United States Department of the Interior, Bureau of Land Management or by a decree of a Court of Law and/or that the corner points mentioned in lines 3, 4 and 5 above were in conformance with the rules of the Michigan Board of Land Surveyors or by a Decree of a Court of Law; established, re-established, monumented, re-monumented, recovered, found as expressed below:

A	B	C	D	E	F	G	H	I	J	K	L
1											
2	6		5		4		3		2		1
3											
4	7		8		9		10		11		12
5											
6	18		17		16		15		14		13
7											
8	19		20		21		22		23		24
9											
10	30		29		28		27		26		25
11											
12	31		32		33		34		35		36
13											


NOTE: Not more than 4 corners, all in the same town and range, may be recorded on this certificate.

A. Description of original monument and accessories and/or subsequent restoration:  
ORIGINAL MONUMENT: POST SET BY J. WAMPLER, U.S. DEPUTY SURVEYOR, FEB. 13, 1824. WITNESSED AS: LYNN 12", N25 1/2W, 31 1/2LINKS.  
BEECH 6", S36E, 46 LINKS

1) CORNER SET AND RECORDED IN LIBER 5, PAGE 287 OF CORNERS, BY R. LESTER, P.S. NO. 18998, AUG. 10, 1979, "EXCAVATED A HOLE 12' X 13' TO AN AVERAGE DEPTH OF 2.5' ON THE CENTERLINE OF MERIDIAN ROAD AND ON FENCE LINE TO WEST. FOUND 12" CULVERT, 1.9' BELOW ROAD SURFACE RUNNING AT AN ANGLE TO THE SOUTHEAST THROUGH EXCAVATION SITE. FOUND NO PHYSICAL EVIDENCE OF MONUMENTATION. CORNER CONSIDERED TO BE LOST WHEN CULVERT WAS INSTALLED. CORNER RE-ESTABLISHED BY PLACING MIDWAY AND ON LINE BETWEEN M-5 AND M-7." CORNER FELL 4.8' WEST OF CENTERLINE AND 6' SOUTH OF THE FENCE TO THE WEST. EXCAVATION BY INGHAM COUNTY CETA CREW, CIRCA LATE 1970'S.  
"SET 4' X 36" CONCRETE MONUMENT WITH 1/2" X 38" REROD AND CAP #18998"  
NAIL AND TAG, #18998, SOUTH SIDE FENCE POST, WNW, 24.88'  
NAIL AND TAG, #18998, NORTH SIDE 4" POPLAR, NW, 31.56' (GONE)  
HOLE IN TOP, NORTH END, CENTERLINE CMP, WNW, 20.83'  
HOLE IN TOP, SOUTH END, CENTERLINE CMP, WSW, 24.97'

B. Description of corner evidence found and/or method applied in restoring or reestablishing corner:  
FOUND THE 4" CONCRETE MONUMENT AND CAP AS DESCRIBED ABOVE, 4.5 FEET WEST OF CENTERLINE OF MERIDIAN ROAD AND 6 FEET SOUTH OF A FENCE TO THE WEST. DUE TO THE EXTENSIVE EXCAVATION IN 1979 ACCEPTED THE POSITION OF THE MONUMENT AS A PROPER METHOD OF ESTABLISHING A LOST CORNER. LEFT THE MONUMENT IN POSITION AND SET A STEEL COLLAR AND COVER TO SURFACE OF MERIDIAN ROAD OVER AN EXISTING CONCRETE COLLAR.

C. Description of monument for corner and accessories established to perpetuate locating the position of the corner:  
4" CONCRETE MONUMENT AND CAP NO. 18998 4.5 FEET WEST OF CENTERLINE OF MERIDIAN ROAD IN STEEL COLLAR OVER CONCRETE MONUMENT BOX.  
FOUND NAIL AND TAG NO. 18998 SOUTH/SIDE 12" WOOD ANCHOR POST, AZ. 290 DEG., 24.88 FEET  
FOUND HOLE IN NORTH END OF 12" CMP UNDER MERIDIAN ROAD, AZ. 289 DEG., 20.83 FEET  
FOUND HOLE IN SOUTH END OF 12" CMP UNDER MERIDIAN ROAD, AZ. 230 DEG., 24.78 FEET  
SET 1/2" BAR AND CAP NO. 18994 IN SHOULDER OF MERIDIAN ROAD, AZ. 90 DEG., 22.77 FEET

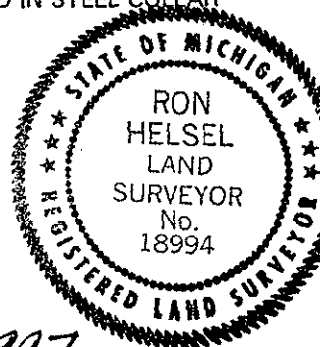

Signed by Ron Helsel Date SEPT. 27, 1997  
Surveyor's Michigan License No. 18994