

DEC 17 1998

SECTION

LAND CORNER RECORDATION CERTIFICATE  
Filing Requirement of Act 74, Mich. P.A. 1970

Liber 9 Page 330

For corners in

<u>INGHAM</u> (County)	Located In: ALAIEDON TOWNSHIP	Corner Code # M-7
1. Public Land Survey	T <u>3N</u> R <u>1W</u>	<u>M-7</u>
	T _____ R _____	_____
	T _____ R _____	_____
	T _____ R _____	_____
2. Property Controlling in Section	S _____ T _____ R _____	_____
	S _____ T _____ R _____	_____
3. Miscellaneous Property in Sec.	S _____ T _____ R _____	_____
	S _____ T _____ R _____	_____

FILED

980047781  
09/18/1998 13:20:22  
REGISTER OF DEEDS  
Paula Johnson  
INGHAM COUNTY, MI

Register of Deeds Stamp & File Number

4. Lot No. \_\_\_\_\_, Recorded Plat \_\_\_\_\_  
5. Private Claims \_\_\_\_\_

I, RON HELSEL, in a field survey on JUNE 30 & JULY 7, 1998 do hereby certify that under requirements of P.A. 74, Michigan P.A. of 1970, the corner points mentioned in lines 1 and 2 above were in conformance with regulations and rules therefore as required in the current manual of survey instructions of the United States Department of the Interior, Bureau of Land Management or by a decree of a Court of Law and /or that the corner points mentioned in lines 3, 4 and 5 above were in conformance with the rules of the Michigan Board of Land Surveyors or by a Decree of a Court of Law; established, re-established, monumented, re-monumented, recovered, found as expressed below:

A	B	C	D	E	F	G	H	I	J	K	L	M
1												
2	6		5		4		3		2		1	
3												
4	7		8		9		10		11		12	
5												
6	18		17		16		15		14		13	
7												
8	19		20		21		22		23		24	
9												
10	30		29		28		27		26		25	
11												
12	31		32		33		34		35		36	
13												


NOTE: Not more than 4 corners, all in the same town and range, may be recorded on this certificate.

A. Description of original monument and accessories and/or subsequent restoration:  
ORIGINAL MONUMENT: POST SET BY JOSEPH WAMPLER, U. S. DEPUTY SURVEYOR, FEB. 1824. BEECH, 10", N61W, 11 LINKS  
R. OAK, 26", N43W, 21 1/2 LINKS

- 1) I.C.R.C. GRID MAPS CALLED FOR: 8" ASH N.E. 51.91' (GONE); 6" HICKORY N.N.W. 85.7' (GONE); T.P. SW 40.0' (GONE); PURE OIL SIGN S.S.E. 82.1' (GONE)
- 2) A L.C.R.C. WAS RECORDED IN LIBER 3, PAGE 313, FIELD DATED OCT. 21, 1974 BY M. FOUTY P.S. NO. 18989. "EXCAVATED 2.5'; FOUND 1" IRON BAR - RAISED WITH 1/2" BAR IN MONUMENT BOX IN CENTERLINE OF MERIDIAN ROAD, 4.5' SOUTH OF CENTERLINE HOLT RD."
- 3) P.A. 132 SURVEY, LIBER 4, PAGE 711, MAY 3, 1983, G. YOUNG P.S. NO. 17640. "FND. 1/2" BAR IN MON. BOX; TAG & NAIL EAST SIDE UTILITY POLE, NNE 281.28' (GONE); 1/2" BAR (ICRC) P.I. IRON NORTH, 4.35' (FOUND); 1/2" IRON BAR EAST, 32.27' (GONE); CENTER OF STREET SIGN POST, SW, 41.35' (NO CLUE TO WHAT THIS REFERS TO).
- 4) P.A. 132 SURVEY, LIBER 4, PAGE 1076, JUNE 5, 1984, M. FOUTY. GAVE SAME WITNESSES AS SURVEY IN P.A. 132, 2-A ABOVE.

B. Description of corner evidence found and/or method applied in restoring or reestablishing corner:  
FOUND 1/2" REBAR IN MONUMENT BOX AND IN THE CENTERLINE OF MERIDIAN ROAD, 4.35 FEET SOUTH OF THE I.C.R.C. P.I. AS DESCRIBED BY SURVEYOR G. YOUNG. IN 1997, EXCAVATED DOWN TO A 3/4" CAPPED PIPE ABOUT 2 FEET AS ACCEPTED BY SURVEYOR M. FOUTY. CONSTRUCTION FOR UNDER GROUND FIBER CABLE HAS DESTROYED ALL THE SUBSEQUENT WITNESSES FOR THIS CORNER. SEARCHED FOR EVIDENCE OF THE PURE OIL SIGN, WHICH I RECALL AS EXISTING IN THE EARLY 1960'S ACCEPTED THE POSITION OF THE 1/2" REBAR AS FAITHFUL PERPETUATION OF THE CORNER. SET A PLASTIC CAP STAMPED P.A. 345, P.S. NO. 18994 OVER THE 1/2" REBAR.

C. Description of monument for corner and accessories established to perpetuate locating the position of the corner:  
1/2" IRON BAR AND CAP ON CENTERLINE OF MERIDIAN ROAD AND 4.5 FEET SOUTH OF THE CENTERLINE OF HOLT ROAD TO THE WEST.  
SET 1/2" IRON BAR & CAP NO. 18994 AT EAST EDGE OF MERIDIAN ROAD 5" DEEP, AZ. 160°, 27.27 FEET  
FOUND 1/2" REBAR (SET CAP NO. 18994) BETWEEN LEGS OF STOP SIGN, AZ. 260°, 64.39 FEET  
FOUND 1/2" REBAR EAST, 33.00 FEET  
SET 1/2" BAR & CAP NO. 18994 BETWEEN LEGS OF ALAIEDON TWP. SIGN, AZ. 288°, 136.61 FEET  
SET 1/2" BAR & CAP NO. 18994, AZ. 320°, 66.23 FEET

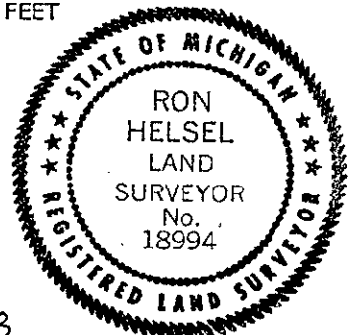

Signed by Ron Helsel  
Surveyor's Michigan License No. 18994

Date Aug. 10, 1998

P.A. 345 INGHAM COUNTY  
PEER APPROVED 8/11/98 M