

FILED

DEC 14 1993

COMMISSION

LAND CORNER RECORDATION CERTIFICATE
Filing Requirement of Act 74, Mich. P.A. 1970

DEC 2 12 18 PM '93

For corners in

REGISTER OF DEEDS

INGHAM
(County)

Located In:

Corner Code =#

Richard W. Steadman

INGHAM COUNTY, MICH.

DELHI TOWNSHIP

1. Public Land Survey

T 3N R 2W M-7

T _____ R _____

T _____ R _____

T _____ R _____

2. Property Controlling in Section

S _____ T _____ R _____

S _____ T _____ R _____

3. Miscellaneous Property in Sec.

S _____ T _____ R _____

S _____ T _____ R _____

Register of Deeds Stamp & File Number

4. Lot No. _____, Recorded Plat _____

5. Private Claims _____

	A	B	C	D	E	F	G	H	I	J	K	L	M
2	6		5		4		3		2		1		
3													
4	7		8		9		10		11		12		
5													
6	16		17		18		19		20		21		22
7													
8	19		20		21		22		23		24		
9													
10	30		29		28		27		26		25		
11													
12	31		32		33		34		35		36		
13													

I, R. W. Steadman, in a field survey on September 10, 1993, do hereby certify that under requirements of P.A. 74, Michigan P.A. of 1970, the corner points mentioned in lines 1 and 2 above were in conformance with regulations and rules therefore as required in the current manual of survey instructions of the United States Department of the Interior, Bureau of Land Management or by a decree of a Court of Law and/or that the corner points mentioned in lines 3, 4 and 5 above were in conformance with the rules of the Michigan Board of Land Surveyors or by a Decree of a Court of Law; established, re-established, monumented, re-monumented, recovered, found as expressed below:

NOTE: Not more than 4 corners, all in the same town and range, may be recorded on this certificate.

A. Description of original monument and accessories and/or subsequent restoration:

1. Original Post Set by Lucius Lyon D.S. in Jan 1825
Beech 11 S28°W 65
Sugar 14 N37W 11
GLO Notes for A-7 Alaiedon call for intersecting Township line 38 Links (25.08) North of Post
2. A. Jackson used corner in a Survey dated in Mar. 1841 recorded in Vol 1 page 69 with no mention of monument or witnesses

(OVER)

B. Description of corner evidence found and/or method applied in restoring or reestablishing corner:


Searched apparent area of corner and found 1" bar in Monument box matching all of Surveyor Fouty's witnesses. Could not remove bar to excavate. Probed bottom of box and hit what is definitely a stone at 3.5'. Accepted 1" bar on top of stone as corner.

Field Work performed by Dave Clifford PS # 25837

C. Description of monument for corner and accessories established to perpetuate locating the position of the corner:

1" Solid Steel Bar in Monument box on centerline Holt and College Roads

Found Nail and Tag # 18998 (R. Lester) in S.E. Side Util. Pole Az. 143° 68.80'
Found Nail and tag # 28414 (M. Mahieu) in W. Side Util Pole Az 19° 83.10'
S.W. Corner Angle Iron Fence Post Az 150° 90.10'
3/4 Bar in Mon. Box Az 0° 25.15'
Set nail and tag #25837 in S.E. side power pole Az. 24° 59.70'

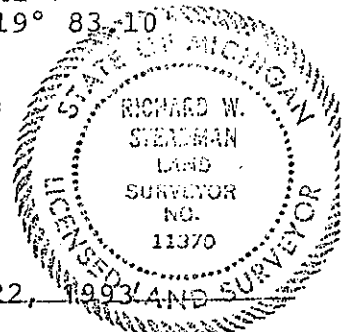

Signed by *Richard W. Steadman* Date NOVEMBER 22, 1993

Surveyor's Michigan License No. 11370

FORM APPROVED BY MICHIGAN STATE BOARD OF LAND SURVEYORS, JAN. 28, 1971
REVISED MAY 14, 1975
REVISED JAN., 1983

P.A. 345 INGHAM COUNTY
PEER APPROVED 11/23/1993 ll

3. T.J. Brown Dep. County Surveyor used corner in a Survey dated Aug. 1844 recorded in Vol C page 5 Co. Surveyors Records with no mention of monument or witnesses.
4. T.J. Brown Deputy Co. Surveyor used corner in a survey dated Dec. 1867 with no mention of monument or witnesses.
5. Nothstine Notes-so called-M.Berryman's (former County Surveyor) personal records call for a stone iron shaft on top.
6. C.E. Smith MDSH Party Chief witnessed corner in 1963.
T.P. S60W 66.95'
P.P. N15E 81.45'
T.P. s60E 109.07'
7. Marv Fouty LS#18989 recorded corner in May 1975 in Liber 3 of corners page 379 as a found 1" Bar in Monument box from witnesses supplied by MDSH.
Iron Bar in Monument box from witnesses supplied by MDSH
Iron Bar in Monument box N. 25.08' SW Corner. Sec 18, T3N, R1W
Nail and cap in Telephone pole SW 68.50'
Nail and cap in Power Pole NE 83.20'.