

DEC 14 1993

COMMISSION

LAND CORNER RECORDATION CERTIFICATE
Filing Requirement of Act 74, Mich. P.A. 1970

DEC 7 12 19 1993

REGISTER OF DEEDS

Richard W. Steadman

INGHAM COUNTY, MICH.

For corners in

<u>Ingham County</u> (County)	Located In:	Corner Code #
Delhi Township	T <u>3N</u> R <u>2W</u>	<u>M-8</u>
1. Public Land Survey	T _____ R _____	_____
	T _____ R _____	_____
	T _____ R _____	_____
2. Property Controlling in Section	S _____ T _____ R _____	_____
	S _____ T _____ R _____	_____
3. Miscellaneous Property in Sec.	S _____ T _____ R _____	_____
	S _____ T _____ R _____	_____
4. Lot No. _____, Recorded Plat _____		
5. Private Claims _____		

Register of Deeds Stamp & File Number

	A	B	C	D	E	F	G	H	I	J	K	L	M
2	6		5		4		3		2		1		
3													
4	7		8		9		10		11		12		
5													
6	18		17		16		15		14		13		
7													
8	19		20		21		22		23		24		
9													
10	30		29		28		27		26		25		
11													
12	31		32		33		34		35		36		
13													

I, Richard W. Steadman, in a field survey on September 10, 19 93, do hereby certify that under requirements of P.A. 74, Michigan P.A. of 1970, the corner points mentioned in lines 1 and 2 above were in conformance with regulations and rules therefore as required in the current manual of survey instructions of the United States Department of the Interior, Bureau of Land Management or by a decree of a Court of Law and/or that the corner points mentioned in lines 3, 4 and 5 above were in conformance with the rules of the Michigan Board of Land Surveyors or by a Decree of a Court of Law; established, re-established, monumented, re-monumented, recovered, found as expressed below:

NOTE: Not more than 4 corners, all in the same town and range, may be recorded on this certificate.

A. Description of original monument and accessories and/or subsequent restoration:

Post set in original survey by Lucious Lyon, Deputy Surveyor in January 1826; Ironwood 7" S15°W 29 LKS. Sugar 26" N33 1/2°W 26 LKS. Corner Recorded by T.J. Brown, County Surveyor in August, 1844 in Volume C. page 3 and again in April, 1851 in Volume C page 20 Ingham County Surveyors Records with the same witnesses as GLO

(continued on back)


B. Description of corner evidence found and/or method applied in restoring or reestablishing corner:

Searched area at apparent location of corner and found 4" Conc. monument in mon. box. (box set by Road Commission) with R. Lesters P. Pole witness intact and one of his Elm Witnesses still standing. The Corner falls on the centerline of College Road and there are no fence lines to West. Adjacent Apparent property lines agree dimension wise with Location of corner. Accepted 4" Conc. monument in monument box. as Corner.

C. Description of monument for corner and accessories established to perpetuate locating the position of the corner:

4" Conc. Monument with cap #18998 in monument Box. Found Nail & Tag #18998 in South Side Power Pole Az., 250°, 45.53' Set Nail & Tag #25837 (PS David Clifford) in South Side 10" Pine, Az., 267°, 85.87' Set Nail & Tag #25837 in SW Side 8" Elm, Az. 119°, 37.60' Found Nail & Tag #28414 (PS M.H. Mahieu) in South Side Power Pole Az. 45°, 97.07' 4" Conc. Mon. in Box (A-8 Alaedon Township), North 22.68'

Signed by *Richard W. Steadman* Date October 11, 1993
Surveyor's Michigan License No. 11370

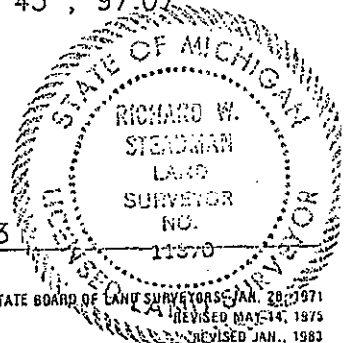

FORM APPROVED BY MICHIGAN STATE BOARD OF LAND SURVEYORS JAN. 28, 1971
REVISED MAY 14, 1975
REVISED JAN., 1983

P.A. 345 INGHAM COUNTY
PEER APPROVED 10/28/93 MC

258?

Ronnie M. Lester LS#18998 Recorded Corner in November 1978 in L. 5 of Corners Page 77 Ingham County Records. He reported that after excavating and finding nothing during the Ingham County Remonumentation Project of the Late 1970's he set a 4"x36" Conc. Monument and conc. collar midway and on line between M-7 and M-9

Nail & Tag #18998, South side Power Pole, West 45.60'

Nail & Tag #18998, South side 10" Pine, WNW, 88.73'

Nail & Tag #18998, South side 4" Elm, ENE 67.95'

Nail & Tag #18998, South side 4" Elm, East 45.19'

Nail & Tag #18998, South side 4" Elm, East 37.51'

4" Concrete monument with concrete collar at A-8 Alaidon Township, North 22.68'