

DEC 14 1993

COMMISSION

LAND CORNER RECORDATION CERTIFICATE  
Filing Requirement of Act 74, Mich. P.A. 1970

DEC 2 12 20 PM '93

REGISTER OF DEEDS  
*Paul Johnson*  
INGHAM COUNTY, MICH.

For corners in

<u>Ingham County</u> <small>(County)</small>	Located In:	Corner Code ##
<u>Delhi Township</u>		
1. Public Land Survey	T <u>3N</u> R <u>2W</u>	<u>M-9</u>
	T _____ R _____	_____
	T _____ R _____	_____
	T _____ R _____	_____
2. Property Controlling in Section	S _____ T _____ R _____	_____
	S _____ T _____ R _____	_____
3. Miscellaneous Property in Sec.	S _____ T _____ R _____	_____
	S _____ T _____ R _____	_____

Register of Deeds Stamp & File Number

- 4. Lot No. \_\_\_\_\_, Recorded Plat \_\_\_\_\_
- 5. Private Claims \_\_\_\_\_

A	B	C	D	E	F	G	H	I	J	K	L	M
2	6	5	4	3	2	1						
3												
4	7	8	9	10	11	12						
5												
6	18	17	16	15	14	13						
7												
8	19	20	21	22	23	24						
9												
10	30	29	28	27	26	25						
11												
12	31	32	33	34	35	36						
13												

I, Richard W. Steadman, in a field survey on September 10, 19 93, do hereby certify that under requirements of P.A. 74, Michigan P.A. of 1970, the corner points mentioned in lines 1 and 2 above were in conformance with regulations and rules therefore as required in the current manual of survey instructions of the United States Department of the Interior, Bureau of Land Management or by a decree of a Court of Law and/or that the corner points mentioned in lines 3, 4 and 5 above were in conformance with the rules of the Michigan Board of Land Surveyors or by a Decree of a Court of Law; established, re-established, monumented, re-monumented, recovered, found as expressed below:

NOTE: Not more than 4 corners, all in the same town and range, may be recorded on this certificate.

A. Description of original monument and accessories and/or subsequent restoration:

- 1. Original Corner set by Lucious Lyon D.S. in January 1826  
Ash 7" S17°W 15 LKS  
Maple 5" N28°W 27 LKS
- 2. Corner Recorded by T.J. Brown, County Surveyor in April 1851 in Volume C, page 20, Ingham County Surveyors Records with no mention of monument or witnesses.


(continued on back)

B. Description of corner evidence found and/or method applied in restoring or reestablishing corner:

Searched at apparent location of Corner and got strong magnetic reading 20' ± South of A-9 Alafedon Township. Excavated surface and found Railroad Spike. Removed Railroad Spike and got strong magnetic reading directly beneath it. Excavated and found 1" Pinchpipe 24" long. Removed 1" pipe and got strong magnetic reading directly beneath it. Excavated to a depth of 3.5 feet and hit another bituminous surface with a hole in it and a 1 1/4" pipe in hole. Excepted Railroad Spike, 1" pipe and 1 1/4" pipe as Corner markers and left 1 1/4" pipe in place and set Standard Bar & Cap above it. Corners lies on centerline of College Road with no occupation line to the West. R. Lester's 30" Poplar Witness to East is still standing and closely matches location of Corner.

C. Description of monument for corner and accessories established to perpetuate locating the position of the corner:

Set Standard 3/4" x 24" Iron Bar with P.A.345 cap#11370 in monument box. Set Nail & Tag #25837 (PS David L. Clifford) in South side 30" Poplar, Az., 113°, 62.86'  
CL Road Sign Post, Az., 32°, 69.25'  
Set Nail & Tag #25837 in east side Multiple Maple, Az., 348°, 102.81'  
CL Railroad Crossing Signal Post, Az., 189°, 235.10'  
Boat Spike @ SW Corner Section 18, Alafedon Township, Az., 0°, 20.32'

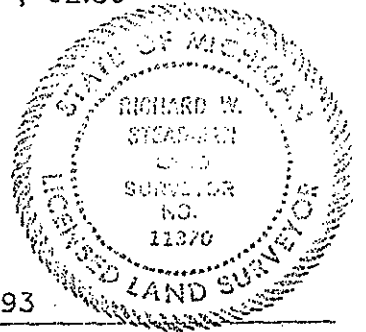

Signed by *Richard W. Steadman* Date October 11, 1993  
Surveyor's Michigan License No. 11370

3. MDSH Surveyor C.E. Smith Witnessed Corner in 1963 as a  
1" Pipe in Center of College Road.  
P. Pole S15°E 149.56'  
15" Poplar S60°E 64.40'
4. Ronnie M. Lester LS#18998 Recorded Corner in November 1977 in Liber 4 of  
Corners, page 115, Ingham County Records as a Found Railroad Spike matching  
MDSH witnesses of 1963  
MDSH tag in west Side power pole SSE, 149.22'  
Nail & Tag in west side 30" Cottonwood, ESE 62.53'  
Nail & Tag in north side 6" Elm, East 64.80'