

Nov 29 9 34 AM '94

REGISTERED DEEDS
INGHAM COUNTY, MICH.

SURVEY & REMONUMENTATION COMMISSION
For corner in Leroy Township, Ingham County, Michigan, located in:
Recorded Plat No. 10 1995

LAND CORNER RECORDATION CERTIFICATE
Filing Requirement of Act 74, Mich. P.A. 1970

Corner Code: //

1. Public Land Survey	T 3N R 2E	G-2
	T R	
	T R	
	T R	
2. Property Controlling in Section	S T R	
	S T R	
3. Miscellaneous Property in Sec.	S T R	
	S T R	
4. Lot No. Recorded Plat		
5. Private Claims		

Register of Deeds Stamp & File Number

	A	B	C	D	E	F	G	H	I	J	K	L	M
2	6		5		4	●	3		2				
3													
4	7		8		9		10		11		12		
5													
6	18		17		16		15		14		13		
7													
8	19		20		21		22		23		24		
9													
10	30		29		28		27		26		25		
11													
12	31		32		33		34		35		36		
13													

I, Larry A. Bryan in a field survey on October 31, 19 94, do hereby certify that under requirements of P.A. 74, Michigan P.A. of 1970, the corner points mentioned in lines 1 and 2 above were in conformance with regulations and rules therefore as required in the current manual of survey instructions of the United States Department of the Interior, Bureau of Land Management or by a decree of a Court of Law and/or that the corner points mentioned in lines 3, 4 and 5 above were in conformance with the rules of the Michigan Board of Land Surveyors or by a Decree of a Court of Law; established, re-established, monumented, re-monumented, recovered, found as expressed below:

NOTE: Not more than 4 corners, all in the same town and range, may be recorded on this certificate.

A. Description of original monument and accessories and/or subsequent restoration:
G-2,

1. Post set in Original Government Survey Joseph Wampler, Deputy Surveyor, in December, 1825, as "set 1/4 post, Beech 7 S11E 27, Beech 3 N22W 12".
2. Corner referred to in a survey by A. Jackson, County Surveyor, on June 22, 1853, (vol. 1, page 309 County Surveyor Records) with no monument given, Beech 3 N22W 12, Sugar 11 N23 1/2E 18 1/2, Beech 7 S11E 27.
(Continued on Back)


B. Description of corner evidence found and/or method applied in restoring or reestablishing corner:

G-2, Investigation at this corner revealed a 1/2" bar and cap #25832 in Anchor Post hole and circle of rocks, with fence lines East, West, North and South with all the witnesses remaining from item #4 and #5. Distances from G-2 to G-3, Rec. 2640.00' from County Surveyor Records, Meas. 2655.76' from item #4. Distances from G-2 to F-2, Rec. 2646.27 from County Surveyor Records Meas. 2659.23' from item #4. Accepted 1/2" bar and cap #25832 as the perpetuated location of G-2 Leroy Township.

C. Description of monument for corner and accessories established to perpetuate locating the position of the corner:

G-2, T3N-R2E
Found 1/2" bar and cap #25832 in Anchor Post hole and circle of rocks.
Set nail & tag #25832 in East side 36" Ash, North, 19.28'.
Set nail & tag #25832 in South side 8" Elm, S80°E 29.32'.
Set nail & tag #25832 in Northwest side 48" Oak, S20°W, 21.19'.
Set nail & tag North side 8" Cherry, West, 23.12'.

Signed by Larry A. Bryan
Surveyor's Michigan License No. 25832

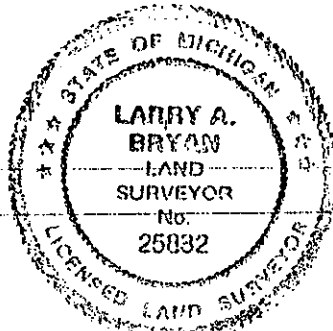

Date 11-23-94

P.A. 345 INGHAM COUNTY
PEER APPROVED 11/09/94 AL

PART "A" CONTINUED

3. Corner referred to in a survey by John McCreary, County Surveyor, on January 22, 1889, (vol. 3, page 35 County Surveyor Records) with no monument or witnesses given.
4. Corner referred to in a unrecorded survey by Larry A. Bryan, P.S. #25832, on March 12, 1992, Job #92-B-36253, as found anchor post hole and circle of rocks with fence lines North, South, East and West. Set nail & tag #25832 in East side 36" Ash, North, 19.28', Set nail & tag #25832 in South side 8" Elm, S80°E 29.32', Set nail & tag #25832 in Northwest side 48" Oak, S20°W, 21.19', Set nail & tag North side 8" Cherry, West, 23.12'.
5. Corner recorded by Larry A. Bryan, P.S. #25832, on March 12, 1992, and recorded in Liber 7 of Corners, Page 261, Ingham County Records, with the same monument and witnesses noted in item #4.