

FILED

**SURVEY & REMONUMENTATION**

**LAND CORNER RECORDATION CERTIFICATE**

Nov 29 9 34 AM '94

For corners in Leroy Ingham County

Filing Requirement of Act 74, Mich. P.A. 1970

REGISTER OF DEEDS  
Ingham County  
INGHAM COUNTY, MICH.

**COMMISSION**

Ingham County

Located In:

Corner Code //

- 1. Public Land Survey T 3N R 2E H-1
- T R
- T R
- T R
- 2. Property Controlling S T R
- in Section S T R
- 3. Miscellaneous S T R
- Property in Sec. S T R

Register of Deeds Stamp & File Number

- 4. Lot No. \_\_\_\_\_, Recorded Plat \_\_\_\_\_
- 5. Private Claims \_\_\_\_\_

	A	B	C	D	E	F	G	H	I	J	K	L	M
2	6	5	4	3	2	1							
3													
4	7	8	9	10	11	12							
5													
6	18	17	16	15	14	13							
7													
8	19	20	21	22	23	24							
9													
10	30	29	28	27	26	25							
11													
12	31	32	33	34	35	36							
13													

I, Larry A. Bryan in a field survey on October 31, 1994, do hereby certify that under requirements of P.A. 74, Michigan P.A. of 1970, the corner points mentioned in lines 1 and 2 above were in conformance with regulations and rules therefore as required in the current manual of survey instructions of the United States Department of the Interior, Bureau of Land Management or by a decree of a Court of Law and/or that the corner points mentioned in lines 3, 4 and 5 above were in conformance with the rules of the Michigan Board of Land Surveyors or by a Decree of a Court of Law; established, re-established, monumented, re-monumented, recovered, found as expressed below:

NOTE: Not more than 4 corners, all in the same town and range, may be recorded on this certificate.

A. Description of original monument and accessories and/or subsequent restoration:  
H-1,

- 1. Corner not set in Original Government Survey.
- 2. H-13, Locke Township, T4N, R2E, referred to in a survey by A. Jackson, County Surveyor, on October 3, 1853, (vol. 1, page 315 County Surveyor Records) with no monument given, witnessed to Beech 7 N66W 80, Beech 12 N22 1/2°E 12 1/2.

(Continued on Back)


B. Description of corner evidence found and/or method applied in restoring or reestablishing corner:

H-1, Investigation at this corner revealed a 1/2" bar and cap #18998 in concrete 4" in diameter in East-West fence. All of the witness trees from item #5 were found with the bearings and distances listed in Part "C". This corner set by the Ingham County Survey and Remonumentation Project and no further field work was done. Accepted 1/2" bar and cap #18998 in 4" diameter concrete as the location of H-1 Leroy Township.

C. Description of monument for corner and accessories established to perpetuate locating the position of the corner:

H-1, T3N-R2E  
Found 1/2" bar and cap #18998 in concrete 4" in diameter in East-West fence.  
Set nail & tag #25832 in East side 20" Beech, N50°W, 22.34'.  
Found nail & tag #18998 in East side power pole, S30°W, 8.83'.  
Set nail & tag #25832 in East side 30" Beech, South, 35.85'.  
Found nail & tag #18998 in West side 28" Maple, S25°W, 28.78'.  
H-13 Locke, 6" iron fence post set in concrete, West 6.30'.

Signed by Larry A. Bryan  
Surveyor's Michigan License No. 25832

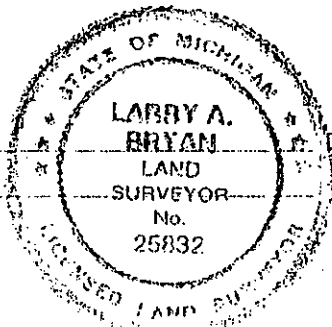

Date 11-23-94

FORM APPROVED BY MICHIGAN STATE BOARD OF LAND SURVEYORS, JAN. 28, 1971  
REVISED MAY 14, 1975  
REVISED JAN., 1983

P.A. 345 INGHAM COUNTY  
PEER APPROVED 11/09/94

## PART "A" CONTINUED

3. H-13, Locke Township, T4N, R2E, referred to in a survey by A. Jackson, County Surveyor, on February 1, 1854 (vol. 1, page 337 County Surveyor Records) with no monument given. Witnessed to: Sugar 18 N70E 10, Maple 13 N36W 50.
4. Corner referred to in a survey by John McCeary, County Surveyor, on January 22, 1889 (vol. 3, page 35 County Surveyor Records) with no monument or witnesses given.
5. Corner recorded by Ronnie M. Lester, P.S. #18998, on May 11, 1981 and recorded in Liber 6, of Corners, Page 197, Ingham County Records, as "Field inspection revealed no evidence of corner. Corner considered lost. Set corner on Township line between G-1 and I-1. Measured East 2651.23' to I-1, Measured West 2651.22' to G-1. Corner falls in East-West fence, 6.30 feet East of fenceline North. Witnessed to: Nail & tag, #18998, East side 20" Beech, N50°W, 22.34', Nail & tag, #18998, East side power pole, S30°W, 8.83', Nail & tag, #18998, East side 30" Beech, South, 35.85', Nail & tag, #18998, West side 44" Maple, S25°W, 28.78', H-13 Locke, 6" iron fence post set in concrete, West 6.30'.
6. H-13 Locke Township recorded by Ronnie M. Lester, P.S. #18998, on May 20, 1981 and recorded in Liber 6, of Corners, Page 201, Ingham County Records, as "Field inspection revealed 6" iron fence post set in concrete with fence North East and West. Distance measured North, West and East are in close accord with GLO measurements. Accepted 6" iron fence post as perpetuated location of H-13. Witnessed to: Nail & tag, #18998, East side 20" Beech, N20°W, 19.06', Nail & tag, #18998, East side power pole, South, 6.71', Nail & tag, #18998, East side 30" Beech, S15°E, 35.92', Nail & tag, #18998, West side 44" Maple, S10°W, 26.00', 4" concrete monument at H-1, Leroy, East 6.30'.