

FEB 22 1996

COMMISSION

LAND CORNER RECORDATION CERTIFICATE

950002192 Liber 8

Filing Requirement of Act 74, Mich. P.A. 1970

For corners in

INGHAM (County) LEROY TOWNSHIP

Located In:

Corner Code #

FILED

11/07/1995 09:05:06 REGISTER OF DEEDS PAULA JOHNSON INGHAM COUNTY, MI

Table with 3 columns: Description, Direction (T/S), and Corner Code #. Includes entries for Public Land Survey, Property Controlling in Section, and Miscellaneous Property in Section.

Register of Deeds Stamp & File Number

4. Lot No. _____, Recorded Plat _____
5. Private Claims _____

Grid table with columns A-K and rows 2-13. Cell G-3 contains the number 3.

I, DAVID R. LOHR, in a field survey on OCTOBER 12, 19 95, do hereby certify that under requirements of P.A. 74, Michigan P.A. of 1970, the corner points mentioned in lines 1 and 2 above were in conformance with regulations and rules therefore as required in the current manual of survey instructions of the United States Department of the Interior, Bureau of Land Management or by a decree of a Court of Law and/or that the corner points mentioned in lines 3, 4 and 5 above were in conformance with the rules of the Michigan Board of Professional Surveyors or by a Decree of a Court of Law; established, re-established, monumented, re-monumented, recovered, found as expressed below:

NOTE: Not more than 4 corners, all in the same town and range, may be recorded on this certificate.

A. Description of original monument and accessories and/or subsequent restoration:


- H-2: 1. CORNER NOT SET DURING ORIGINAL GOVERNMENT SURVEYS
2. RECORDED SURVEYS BY JOHN MCCREARY, COUNTY SURVEYOR, IN 1889.
3. MISC. RECORDS, LIVINGSTON COUNTY SURVEYOR CLAY W. GORDON, DATED 9/29/39, BOOK 5, PG. 4, NO MENTION OF MONUMENT OR WITNESSES.

B. Description of corner evidence found and/or method applied in restoring or reestablishing corner:

H-2 : VISITED APPARENT LOCATION OF CORNER AND FOUND NEW TREATED ANCHOR POST ON FENCE RUNNING NORTH AND EAST-WEST, ALSO FOUND ANOTHER ANCHOR POST LOCATED 11.0 FT. EAST WITH FENCE RUNNING TO THE SOUTH. RETRACED FOUTY'S TRAVERSE OF ITEM A:4, AND SET CORNER AT INTERSECTION OF 1/4 LINES. CORNER FALLS 50 NORTH X 1.2 FT. WEST OF WESTERLY ANCHOR POST. FOUND NO EVIDENCE OF ANCIENT OCCUPATION OTHER THAN SCANT REMAINS OF TREE LINE TO NORTH. SET 3/4" X 24" STANDARD REMON. BAR AND P.A. 345 CAP #30090, 50 FT. NORTH X 1.2 FT. WEST OF ANCHOR POST. DISTANCES TO ADJACENT CORNERS MATCH CLOSELY THOSE OF SURVEYOR CLAY W. GORDON (ITEM A-3)

C. Description of monument for corner and accessories established to perpetuate locating the position of the corner:

H-2 : SET 3/4" X 24" STANDARD REMON. BAR AND P.A. 345 CAP #30090 50 FT. NORTH X 1.2 FT. WEST OF ANCHOR POST. WITNESSED BY: SET. N&T #30090 W/S WOOD FENCE POST AZ. 00-18-36 38.43' SET. N&T #30090 E/S WOOD ANCHOR POST AZ. 165-22-21 53.32' SET. N&T #30090 W/S WOOD ANCHOR POST AZ. 177-34-00 50.74' SET. N&T #30090 SE/S WOOD FENCE POST AZ. 212-26-30 56.02' TRAV.PT. LE1-18-21, 1/2" REBAR/CAP AZ. 211-28-33 108.93' BEARING AND DISTANCE TO G-2 AZ. 273-01-17 2662.20' BEARING AND DISTANCE TO I-2 AZ. 93-01-17 2664.34' BEARING AND DISTANCE TO H-3 AZ. 179-11-36 2650.06' BEARING AND DISTANCE TO H-1 AZ. 359-11-36 1885.93'

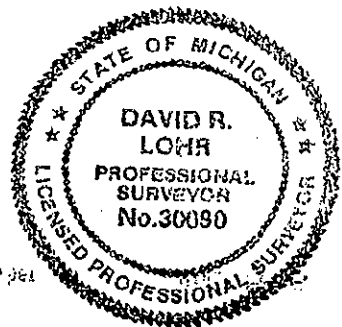

Signed by David R. Lohr

Date 11/1/95

Surveyor's Michigan License No. 30090

H-2: PART A - CONTINUED

4. UNRECORDED SURVEY NUMBER 885, BY MARVIN F. FOUTY, PS #18989, DATED 4/15/93 BREAKS DOWN SOUTH 1/2 OF SECTION 3, LEROY TOWNSHIP, BUT DOES NOT SHOW CENTER OF SECTION AS HAVING BEEN SET. CONTACTED SURVEYOR FOUTY AND OBTAINED COPY OF TRAVERSE NOTES AND COMPUTATION DATA.

RECORDED