

**SURVEY &
REMONUMENTATION**

JAN 18 2001

SECTION

**LAND CORNER RECORDATION CERTIFICATE
Filing Requirement of Act 74, Mich. P.A. 1970**

For corners in

INGHAM COUNTY Located in: Corner Code #
(County)
LEROY TOWNSHIP
1. Public Land Survey T3N R2E K-5
T R
T R
T R
2. Property Controlling S T R
in Section T R
3. Miscellaneous S T R
Property in Sec. S T R

Paula Johnson
INGHAM COUNTY
REGISTER OF DEEDS
ENGER SURVEYING

RECORDED L-10 P-71
CRNR 9.00 2000-048335



2000-048335
Page: 1 of 1
11/14/2000 08:41A

Register of Deeds Stamp & File Number

4. Lot No. _____, Recorded Plat _____
5. Private Claims _____

I, DAVID L. CLIFFORD, in a field survey on AUGUST 18, 2000 Do hereby state that under requirements of P.A. 74, Michigan P.A. of 1970, the corner points mentioned in lines 1 and 2 above were in conformance with regulations and rules therefore as required in the current manual of survey instructions of the United States Department of the Interior, Bureau of Land Management or by a decree of a Court of Law and/or that the corner points mentioned in lines 3, 4 and 5 above were in conformance with the rules of the Michigan Board of Land Surveyors or by a Decree of a Court of Law, established, re-established, monumented, recovered, found as expressed below:

NOTE: Not more than 2 corners, all in the same town and range, may be recorded on this certificate.

	A	B	C	D	E	F	G	H	I	J	K	L	M
1													
2	6		5		4		3		2		1		
3													
4	7		8		9		10		11		12		
5													
6	18		17		16		15		14		13		
7													
8	19		20		21		22		23		24		
9													
10	30		29		28		27		26		25		
11													
12	31		32		33		34		35		36		
13													

A. Description of original monument and accessories and/or subsequent restoration:

1. ORIGINAL POST SET BY J. WAMPLER, DEPUTY SURVEYOR IN DEC 1825; BEECH 12 S41E 23; BEECH 13 N19E 15
2. J. MCGREARY, COUNTY SURVEYOR, USED CORNER IN A SURVEY RECORDED IN VOLUME 3, PAGE 210, INGHAM COUNTY SURVEYORS RECORDS, IN MAR 1889: GAS PIPE NO TREES.
3. W. BERRYMAN, COUNTY SURVEYOR, WITNESSED CORNER IN HIS PRIVATE NOTES AS A GAS PIPE - CROCKERY - ABOUT 1' W. OF FENCE LINE N.: 1" PIPE N. 33.0'; MAPLE 15" S. 22.5'; OAK 20" SSW 24.5'; MAPLE 12" SW 30.5'; MAPLE 12" WSW 43.0'.
4. INGHAM COUNTY ROAD COMMISSION MONUMENT & WITNESSES ARE THE SAME AS BERRYMAN'S.
5. O. BOSS RLS # 13574 RECORDED CORNER IN LIBER 3 PAGE 89 IN APRIL 1974 AND USED CORNER IN ACT 132 SURVEYS RECORDED IN LIBER 1 PAGE 961 IN AUG. 1973 AND IN LIBER 2 PAGE 426 IN DEC. 1974 AS A 1" PIPE FOUND: NAIL E. SIDE 24" MAPLE, SOUTH, 21.93'; NAIL W. SIDE 14" MAPLE, S47°W, 30.23'; NAIL W. SIDE 10" POPLAR, S55°E, 48.52'.

B. Description of corner evidence found and/or method applied in restoring or reestablishing corner:

SEARCHED AT APPARENT LOCATION OF CORNER AND FOUND A 1" X 2' GAS PIPE ON CENTERLINE GRIEB ROAD AND 1' WEST OF FENCE LINE TO SOUTH MATCHING ALL OF BERRYMAN'S, ROAD COMMISSION AND BOSS WITNESSES. EXCAVATED 1' DIAMETER X 2' DEEP HOLE AROUND PIPE AND FOUND BROKEN CROCKERY AROUND PIPE. ACCEPTED PIPE AS CORNER AS PERPETUATED BY EVERYONE MENTIONED ABOVE AND DROVE 3/4" X 24" BAR INTO IT AND CAPPED BAR WITH ALUMINUM CAP AND SET MONUMENT BOX.


C. Description of monument for corner and accessories established to perpetuate locating the position of the corner:

K-5 T3N-R2E
3/4" X 24" STEEL BAR AND 2 1/2" ALUMINUM CAP STAMPED PA 345 LS 25837 INGHAM COUNTY IN MONUMENT BOX
SET NAIL & TAG #25837 IN WEST SIDE 22" MAPLE, S11°W, 22.20'
SET NAIL & TAG #25837 IN NW SIDE 19" MAPLE, S50°W, 30.27'
SET NAIL & TAG #25837 IN NW SIDE 17" MAPLE, S69°W, 42.92'
SET NAIL & TAG #25837 IN NW SIDE 12" OAK, S74°W, 53.55'
SET NAIL & TAG #25837 IN NW SIDE 9" OAK, S78° W, 65.20'
1" PIPE, NORTH 33.01'

Signed by David L. Clifford Date AUGUST 26, 2000

Surveyor's Michigan License No. 25837

FORM APPROVED BY MICHIGAN STATE BOARD OF PROFESSIONAL SURVEYORS, JAN. 28, 1971
REVISED MAY 14, 1975
REVISED JAN. 1983
REVISED OCT., 1995

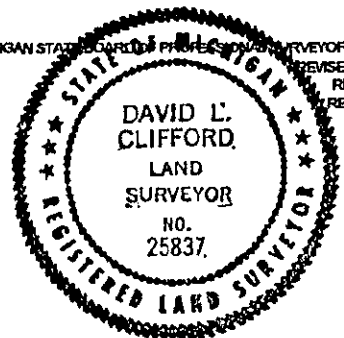

P.A. 345 INGHAM COUNTY
PEER APPROVED 9/7/2000 *M*