

SURVEY & REMONUMENTATION

JAN 18 2001

SECTION

LAND CORNER RECORDATION CERTIFICATE
Filing Requirement of Act 74, Mich. P.A. 1970

For corners in

<u>INGHAM COUNTY</u> (County)	Located In:	Corner Code #
LEROY TOWNSHIP	T <u>3N</u> R <u>2E</u>	<u>K-6</u>
1. Public Land Survey	T _____ R _____	_____
	T _____ R _____	_____
2. Property Controlling in Section	S _____ T _____ R _____	_____
	S _____ T _____ R _____	_____
3. Miscellaneous Property in Sec.	S _____ T _____ R _____	_____

Paula Johnson
INGHAM COUNTY
REGISTER OF DEEDS
ENGER SURVEYING

L-10 P-70

RECORDED

CRNR 9.00

2000-048334



2000-048334

Page: 1 of 1

11/14/2000 08:41A

Register of Deeds Stamp & File Number

4. Lot No. _____, Recorded Plat _____
5. Private Claims _____

I, DAVID L. CLIFFORD, in a field survey on AUGUST 22, 2000, Do hereby state that under requirements of P.A. 74, Michigan P.A. of 1970, the corner points mentioned in lines 1 and 2 above were in conformance with regulations and rules therefore as required in the current manual of survey instructions of the United States Department of the Interior, Bureau of Land Management or by a decree of a Court of Law and /or that the corner points mentioned in lines 3, 4 and 5 above were in conformance with the rules of the Michigan Board of Land Surveyors or by a Decree of a Court of Law, established, re-established, monumented, recovered, found as expressed below:

NOTE: Not more than 2 corners, all in the same town and range, may be recorded on this certificate.

	A	B	C	D	E	F	G	H	I	J	K	L	M
1													
2	6		5		4		3		2		1		
3													
4	7		8		9		10		11		12		
5													
6	18		17		16		15		14	⊙	13		
7													
8	19		20		21		22		23		24		
9													
10	30		29		28		27		26		25		
11													
12	31		32		33		34		35		36		
13													

A. Description of original monument and accessories and/or subsequent restoration:

1. ORIGINAL POST SET BY J. WAMPLER, DEPUTY SURVEYOR IN DEC 1825; IRONWOOD 3 S34½W 8; SUGAR 9 N13W 9
2. E. A. CALKINS, COUNTY SURVEYOR, USED CORNER IN A SURVEY RECORDED IN VOLUME 5, PAGE 151, INGHAM COUNTY SURVEYORS RECORDS, IN AUG 1900: O.P.F. AND O.W.I. SET 3/4" GAS PIPE AND PLOW SHOE FOR CORNER.
3. O. BOSS RLS # 13574 RECORDED CORNER IN LIBER 3 PAGE 89 IN APR. 1974 AND USED IT IN AN ACT 132 SURVEY RECORDED IN LIBER 1 PAGE 961 IN DEC. 1973 AS A FOUND 3/4" PIPE: S58W. 50.88' NAIL N/S 12" ASH; S73W 91.88' NAIL N/S 12" ASH; NORTH 18.78' NAIL E/S TELE. POLE.
4. M. DYER, RLS # 21565 USED CORNER IN AN ACT 132 SURVEY RECORDED IN LIBER 4 PAGE 434 IN OCT. 1981 WITH SAME MONUMENT AND WITNESSES AS IN ITEM 3 ABOVE.
5. M. MAHIEU PS # 28414 USED CORNER IN AN ACT 132 SURVEY RECORDED IN LIBER 7 PAGE 899 IN AUG. 1996 AS A FOUND 3/4" PIPE: N&T #28414 W. SIDE 24" ELM, S5°E, 36.50'; N&T #28414 W. SIDE 12" MAPLE, SOUTH, 37.05'; N&T #28414 N. SIDE 24" WALNUT S55°W, 50.23'; N&T #28414 N. SIDE 8" WALNUT, S70°W, 63.04'.

B. Description of corner evidence found and/or method applied in restoring or reestablishing corner:

SEARCHED AT APPARENT LOCATION OF CORNER AND FOUND A 3/4" PIPE WITH PLOW SHARE ALONGSIDE 2' NORTH OF CENTERLINE GRAVEL TOWNSEND ROAD ON FENCE LINE TO SOUTH MATCHING BOSS, DYER AND MAHIEU WITNESSES. EXCAVATED 1' DIAMETER X 2' DEEP HOLE AROUND PIPE AND FOUND NOTHING MORE. ACCEPTED PIPE AS CORNER AS PERPETUATED BY EVERYONE MENTIONED ABOVE AND SET STANDARD BAR & CAP ABOVE IT.


C. Description of monument for corner and accessories established to perpetuate locating the position of the corner:

K-6 T3N-R2E
3/4" X 24" STEEL BAR AND 2 1/4" ALUMINUM CAP STAMPED PA 345 LS 25837 INGHAM COUNTY
SOUTH EDGE 2" ANGLE IRON FENCE POST IN CONCRETE AT GROUND LEVEL, N40°E, 24.38'
SET NAIL & TAG #25837 IN WEST SIDE 10" WALNUT, SOUTH, 42.55'
FOUND NAIL & TAG #28414, IN NORTH SIDE 15" WALNUT, S68°W, 50.21'
SET NAIL & TAG #25837 IN EAST SIDE 6" LOCUST, N14°W, 36.86'

Signed by David L. Clifford

Date AUGUST 26, 2000

Surveyor's Michigan License No. 25837

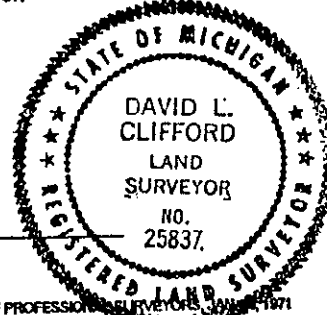

FORM APPROVED BY MICHIGAN STATE BOARD OF PROFESSIONAL SURVEYORS, JAN 14, 1975
REVISED JAN, 1983
REVISED OCT, 1985

P.A. 345 INGHAM COUNTY
PEER APPROVED 9/7/2000 RW