

SURVEY & REMONIMENTATION

JAN 18 2001

SECTION

LAND CORNER RECORDATION CERTIFICATE
Filing Requirement of Act 74, Mich. P.A. 1970

For corners in

INGHAM COUNTY Located in: Corner Code #
(County)
LERoy TOWNSHIP
1. Public Land Survey T 3N R 2E K-7
T R
T R
T R
2. Property Controlling S T R
in Section T R
3. Miscellaneous S T R
Property in Sec. S T R

Paula Johnson
INGHAM COUNTY
REGISTER OF DEEDS
ENGER SURVEYING

RECORDED

L-10 P-69

CRNR 9.00

2000-048333



2000-048333

Page: 1 of 1

11/14/2000 08:41A

Register of Deeds Stamp & File Number

4. Lot No. _____, Recorded Plat _____
5. Private Claims _____

I, DAVID L. CLIFFORD, in a field survey on AUGUST 29, 2000 Do hereby state that under requirements of P.A. 74, Michigan P.A. of 1970, the corner points mentioned in lines 1 and 2 above were in conformance with regulations and rules therefore as required in the current manual of survey instructions of the United States Department of the Interior, Bureau of Land Management or by a decree of a Court of Law and for that the corner points mentioned in lines 3, 4 and 5 above were in conformance with the rules of the Michigan Board of Land Surveyors or by a Decree of a Court of Law, established, re-established, monumented, recovered, found as expressed below:

	A	B	C	D	E	F	G	H	I	J	K	L	M
1													
2	6		5		4		3		2		1		
3													
4	7		8		9		10		11		12		
5													
6	18		17		16		15		14		13		
7													
8	19		20		21		22		23		24		
9													
10	30		29		28		27		26		25		
11													
12	31		32		33		34		35		36		
13													

NOTE: Not more than 2 corners, all in the same town and range, may be recorded on this certificate.

A. Description of original monument and accessories and/or subsequent restoration:

1. ORIGINAL POST SET BY J. WAMPLER, DEPUTY SURVEYOR IN DEC 1825; SUGAR 4 N47 1/2 W 17 1/2; SUGAR 10 S80 1/2 E 11 1/2
2. O. BOSS RLS # 13574 RECORDED CORNER IN LIBER 3 PAGE 123 IN MAY 1974 AND USED IT AN ACT 132 SURVEY RECORDED IN LIBER 1 PAGE 1256 IN JUNE 1974 AS A SET IRON AT OLD FENCE CORNER POST: NAIL WEST SIDE 36" TREE, N10°E, 15.50'; NAIL WEST SIDE 10" TREE, S50°E, 35.80; 4" STEEL FENCE POST, NORTH, 1.3'
3. D. CLIFFORD RLS #25837 USED CORNER IN AN ACT 132 SURVEY RECORDED IN LIBER 3 PAGE 1173 IN JULY 1979 WITH NO MENTION OF MONUMENT OR WITNESSES.
4. M. DYER RLS # 21565 USED CORNER IN AN ACT 132 SURVEY RECORDED IN LIBER 4 PAGE 435 IN SEP. 1981 AS A FOUND IRON: NAIL & TAG WEST SIDE 18" LINDEN, N10°E, 30.29'; NAIL & TAG SOUTH SIDE 10" LINDEN, S50°W, 34.37; 4" STEEL FENCE POST, NORTH, 1.3'; NAIL & TAG NORTH SIDE 10" ASH, S40°E, 22.93'

B. Description of corner evidence found and/or method applied in restoring or reestablishing corner:


SEARCHED AT APPARENT LOCATION OF CORNER AND FOUND A 1/2" X 18" BAR & ILLEGIBLE CAP 1.3' SOUTH OF A 4" STEEL CORNER POST IN CONCRETE. BAR & CAP ARE IN AN ANCIENT ANCHOR POST HOLE. CORNER LOCATION MATCHES DYER & BOSS WITNESSES. EXCAVATED 3' DIAMETER X 2' DEEP HOLE AROUND BAR AND FOUND MANY STONES AROUND BAR AND CONCRETE AROUND STEEL FENCE POST TO NORTH. ACCEPTED BAR & CAP AS CORNER AS PERPETUATED BY EVERYONE LISTED ABOVE AND REPLACED BAR & CAP WITH STANDARD BAR AND ALUMINUM PA 345 CAP. MEASURED EAST 2679.62' TO L-7 AND SOUTH 2677.54' TO K-8.

C. Description of monument for corner and accessories established to perpetuate locating the position of the corner:

- K-7 T3N-R2E
3/4" X 24" STEEL BAR AND 2 1/2" ALUMINUM CAP STAMPED PA 345 LS 25837 INGHAM COUNTY
SET NAIL & TAG #25837 IN WEST SIDE 21" BASSWOOD, N20°E, 30.30'
SET NAIL & TAG #25837 IN EAST SIDE 17" BASSWOOD, S50°E, 23.02'
SET NAIL & TAG #25837 IN NORTH SIDE 27" MAPLE, WEST, 45.45'
SET NAIL & TAG #25837 IN WEST SIDE 14" ASH, N10°W, 15.26'
SOUTH FACE 4" STEEL PIPE FENCE POST IN CONCRETE, NORTH, 1.20'

Signed by David L. Clifford
Surveyor's Michigan License No. 25837

Date SEPTEMBER 02, 2000

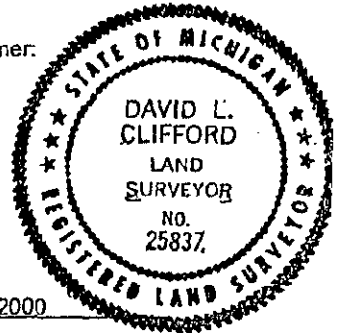

FORM APPROVED BY MICHIGAN STATE BOARD OF PROFESSIONAL SURVEYORS, JAN. 28, 1971
REVISED MAY 14, 1976
REVISED JAN, 1983
REVISED OCT, 1985

P.A. 345 INGHAM COUNTY
PEER APPROVED: 9/7/2000 *RL*