

**SURVEY &
REMONUMENTATION**

DEC 09 1999

LAND CORNER RECORDATION CERTIFICATE
Filing Requirement of Act 74, Mich. P.A. 1970

Liber 9 Page 457

For corners in SECTION

FILED

INGHAM Located In: Corner Code #
(County) LEROY TOWNSHIP

1. Public Land Survey T 3N R 2E M-2
T _____ R _____
T _____ R _____
T _____ R _____

2. Property Controlling S _____ T _____ R _____
in Section S _____ T _____ R _____

3. Miscellaneous S _____ T _____ R _____
Property in Sec. S _____ T _____ R _____

990032916
07/02/1999 09:14:19
REGISTER OF DEEDS
Paula Johnson
INGHAM COUNTY, MI

Register of Deeds Stamp & File Number

4. Lot No. _____, Recorded Plat _____
5. Private Claims _____

I, RON HELSEL, in a field survey on JUNE 2, 1999
do hereby certify that under requirements of P.A. 74, Michigan P.A. of 1970, the corner points mentioned in lines 1 and 2 above were in conformance with regulations and rules therefore as required in the current manual of survey instructions of the United States Department of the Interior, Bureau of Land Management or by a decree of a Court of Law and /or that the corner points mentioned in lines 3, 4 and 5 above were in conformance with the rules of the Michigan Board of Land Surveyors or by a Decree of a Court of Law; established, re-established, monumented, re-monumented, recovered, found as expressed below:

	A	B	C	D	E	F	G	H	I	J	K	L	M
1													
2	6		5		4		3		2		1		
3													
4	7		8		9		10		11		12		
5													
6	18		17		16		15		14		13		
7													
8	19		20		21		22		23		24		
9													
10	30		29		28		27		26		25		
11													
12	31		32		33		34		35		36		
13													

NOTE: Not more that 4 corners, all in the same town and range, may be recorded on this certificate.

A. Description of original monument and accessories and/or subsequent restoration:

ORIGINAL MONUMENT: POST SET BY JOSEPH WAMPLER, U.S. DEPUTY SURVEYOR, IN 1825. SET 40 CHAINS FROM SE CORNER, TAM 11", S60E, 10 LINKS; TAM 10", S85W, 16 LINKS.

1) P.A. 74 CORNER, LIBER 4, PAGE 387, APRIL 15, 1974, P. BENTON, P.S. NO. 19826. "SET 1/2" IRON ROD BY PROPORTIONATE MEASUREMENTS PER GOVERNMENT INFORMATION REGARDING RESTORATION OF LOST OR OBLITERATED CORNERS". NORTH, 12.89 SP. W/S 3" TREE; (GONE) EAST 49.11 SP. W/S 8" DOUBLE TREE; (GONE) S30°E, 83.09 SP. N/S 8" TREE. (FOUND A 20" ASH IN THIS AREA)

2) P.A. 132 SURVEY, LIBER 4, PAGES 1269-1270, MAY 14, 1986, R. LESTER, P.S. NO. 18998. NAIL & TAG, N/SIDE DOUBLE SOFT MAPLE, EAST, 51.4' (GONE) NAIL & TAG W/SIDE 18" ASH, S.S.E., 84.6' (FOUND ASH) NAIL & TAG E/SIDE 8" ELM, S.W. 55.5' (GONE) NAIL & TAG N.E./SIDE 10" ASH, N.W. 22.7 (FOUND 14" ASH)


3) UNRECORDED SURVEY, DATED 3-13-95, BY D. HUGHES P.S. NO. 19834, JOB NO. 95382, FOUND 1/2" IRON AT NE EDGE OF GRAVEL ROAD AT THE INTERSECTION OF THE CENTERLINES EXTENDED FOR WALLACE AND HUSCHKE ROAD. 327° 24.19' SET N&T SW/S 14" OAK (FOUND 14" ASH); 116° 50.33' SET N&T N/S TWIN 20'-14" MAPLE (GONE); 254° 58.55' SET N&T N/S 12" MAPLE (FOUND); 164° 83.66' SET N&T SW/S 24" OAK (FOUND 20" ASH) 180° 66.00' FD. 2" IRON PIPE FOR A-2 HANDY TWP.

B. Description of corner evidence found and/or method applied in restoring or reestablishing corner:

FOUND A 3/4" REBAR OVER A 1/2" REBAR AT THE LOCATION DESCRIBED BY D. HUGHES IN 3-A ABOVE. POSITION OF THE BAR WAS IN ACCORD WITH THE ONE REMAINING WITNESS OF SURVEYOR BENTON IN 1-A ABOVE AND WITH 2 OF THE REMAINING WITNESSES OF SURVEYOR R. LESTER IN 2-A ABOVE. TRAVERSE OF THE EAST LINE OF SECTION 1 FOUND THIS CORNER TO BE 22.4 FEET EAST OF A DIRECT LINE BETWEEN THE NORTHEAST AND THE SOUTHEAST CORNERS OF THE SECTION WHICH MATCHED THE SURVEY BY D. HUGHES IN 2-A ABOVE. EXCAVATED A 6' BY 8' HOLE CONCENTRATED AROUND 15' WEST OF THE 1/2" IRON BAR DOWN 2.5 FEET TO EXISTING CLAY. THIS IS A FILL AREA WITH LOTS OF METAL CLINKERS. DID NOT FIND ANY EVIDENCE OF A PREVIOUS CORNER AND ACCEPTED THE POSITION OF THE BAR AS FAITHFUL PERPETUATION OF THE CORNER. SET A PLASTIC CAP OVER THE 3/4" REBAR STAMPED P.A. 345, P.S. 18994, 6" BELOW THE SURFACE OF THE ROADS.

C. Description of monument for corner and accessories established to perpetuate locating the position of the corner:

3/4" REBAR AND CAP AT NORTHERLY EDGE OF WALLACE AND HUSCHE ROADS.
FOUND NAIL & TAG #19834, WEST/SIDE 14" ASH, AZ. 329°, 24.14 FEET
FOUND NAIL & TAG #19834, NORTH/SIDE POWER POLE AZ. 92°, 35.49 FEET
FOUND NAIL & TAG #19834, NORTH SIDE 12" SOFT MAPLE, AZ. 258°, 58.59 FEET
FOUND NAIL & TAG #19834, SW/SIDE 20" ASH, AZ. 165°, 84.48 FEET
LEDY TRAV. BAR AND CAP, AZ. 338°, 8.07 FEET
SOUTH, 66.02 FEET TO 2" PIPE AT A-2 HANDY TWP.

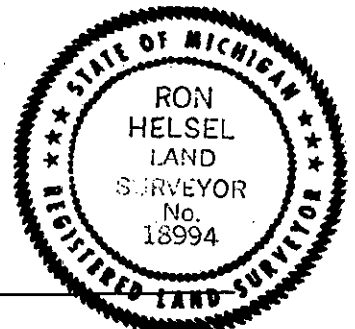

Signed by Ron Helsel Date 6-24-99
Surveyor's Michigan License No. 18994