

# SURVEY & REMONUMENTATION

JAN 18 2001

## LAND CORNER RECORDATION CERTIFICATE Filing Requirement of Act 74, Mich. P.A. 1970

For corners in **SECTION**

<u>INGHAM COUNTY</u>	Located In:	Corner Code #	
(County)			
<b>LEROY TOWNSHIP</b>			
1. Public Land Survey	T <u>3N</u> R <u>2E</u>	<u>M-8</u>	
	T ___ R ___	_____	
	T ___ R ___	_____	
	T ___ R ___	_____	
2. Property Controlling in Section	S ___ T ___ R ___	_____	
	S ___ T ___ R ___	_____	
3. Miscellaneous Property in Sec.	S ___ T ___ R ___	_____	
	S ___ T ___ R ___	_____	

Paula Johnson  
INGHAM COUNTY  
REGISTER OF DEEDS  
ENGER SURVEYING

**L-10 P-56**

RECORDED CRNR 9.00 2000-048320

2000-048320  
Page: 1 of 1  
11/14/2000 08:41A

Register of Deeds Stamp & File Number

4. Lot No. \_\_\_\_\_, Recorded Plat \_\_\_\_\_  
5. Private Claims \_\_\_\_\_

I, DAVID L. CLIFFORD, in a field survey on AUGUST 21, 2000. Do hereby state that under requirements of P.A. 74, Michigan P.A. of 1970, the corner points mentioned in lines 1 and 2 above were in conformance with regulations and rules therefore as required in the current manual of survey instructions of the United States Department of the Interior, Bureau of Land Management or by a decree of a Court of Law and/or that the corner points mentioned in lines 3, 4 and 5 above were in conformance with the rules of the Michigan Board of Land Surveyors or by a Decree of a Court of Law, established, re-established, monumented, recovered, found as expressed below:

**NOTE:** Not more than 2 corners, all in the same town and range, may be recorded on this certificate.

	A	B	C	D	E	F	G	H	I	J	K	L	M
1													
2	6		5		4		3		2		1		
3													
4	7		8		9		10		11		12		
5													
6	18		17		16		15		14		13		
7													
8	19		20		21		22		23		24		
9													
10	30		29		28		27		26		25		
11													
12	31		32		33		34		35		36		
13													

**A. Description of original monument and accessories and/or subsequent restoration:**

1. ORIGINAL POST SET BY J. WAMPLER, DEPUTY SURVEYOR IN FEB. 1824; ASPEN 18 N58W 22; B.OAK 20 S85E 15
2. A. JACKSON, COUNTY SURVEYOR, USED CORNER IN A SURVEY RECORDED IN LIBER 3 PAGE 279, INGHAM COUNTY SURVEYORS RECORDS, IN MARCH 1856: ELM 15, S31W, 5 LKS; ASH 9, S80E, 7 LKS.
3. J. MCCREARY, COUNTY SURVEYOR, USED CORNER IN A SURVEY RECORDED IN FOLDER SET #2 PAGE 33 ( FOLDER SET # 2 IS IN LARGE WHITE BOX IN REGISTER OF DEEDS OFFICE) IN OCT. 1897: IRON & BRICK & CROCKERY.
4. O. BOSS, RLS # 13574, RECORDED CORNER IN LIBER 3 PAGE 123 IN MAR. 1974 AND USED IT IN ACT 132 SURVEYS RECORDED IN LIBER 1 PAGE 1256 IN JUNE 1974 AND LIBER 2 PAGE 879 IN SEP. 1976 AS A FOUND 3/4" BOLT: N80°W, 65.50', NAIL S/S 12" TREE; N75°W, 42.91' NAIL S/S 20" TREE; S55°E, 38.50' USGS BM.

**B. Description of corner evidence found and/or method applied in restoring or reestablishing corner:**


SEARCHED AT APPARENT LOCATION OF CORNER AND FOUND A 1/2" BAR ON CENTERLINE WALLACE ROAD AND 7.5' NORTH OF CENTERLINE VAN ORDEN ROAD MATCHING 1 REMAINING BOSS WITNESSES TO NW. EXCAVATED 2' DIAMETER HOLE 18" DEEP AROUND IRON AND FOUND 3/4" BOLT WITH 1" SQUARE HEAD BENEATH IT SURROUNDED BY BROKEN BRICK AND CROCKERY. ACCEPTED BOLT AS PERPETUATION OF CORNER BY MCCREARY AND REPLACED IT WITH STANDARD BAR & ALUMINUM CAP AND SET MONUMENT BOX.

**C. Description of monument for corner and accessories established to perpetuate locating the position of the corner:**

M-8 T3N-R2E  
3/4" BAR X 24" STEEL BAR AND 2 1/4" ALUMINUM CAP STAMPED PA 345 LS 25837 INGHAM COUNTY IN MONUMENT BOX SE CORNER FDN. HOUSE #1746, N51°E, 139.37'  
FOUND NAIL & TAG #19834 (D. HUGHES) IN SE SIDE UTIL. POLE, N35°E, 41.84'  
FOUND NAIL & TAG #25832 (L. BRYAN) IN WEST SIDE 8" X 8" WOOD CORNER POST, S35°E, 43.24'  
1-1/4" PIPE WITH 3" ALUMINUM CAP STAMPED A-8 T3N, R3E RLS 19834, SOUTH 101.83'  
PK NAIL IN NORTH SIDE 28" MAPLE, N51°W, 43.43'

Signed by David L. Clifford  
Surveyor's Michigan License No. 25837

Date AUGUST 06, 2000

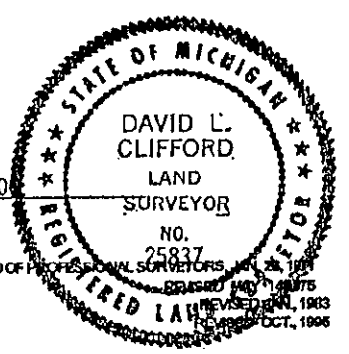

FORM APPROVED BY MICHIGAN STATE BOARD OF PROFESSIONAL SURVEYORS, JAN. 24, 1975  
REVISED APR. 1975  
REVISED APR. 1983  
REVISED OCT. 1995

P.A. 345 INGHAM COUNTY  
PEER APPROVED 9/7/2000 MC