

**SURVEY & REMONUMENTATION**

DEC 6 1999

SECTION

Paula Johnson  
INGHAM COUNTY  
REGISTER OF DEEDS  
REGISTER SURVEYING & ENGINEER

**L-9 P-488**

RECORDED CRNR 9.00

1999-050550

**LAND CORNER RECORDATION CERTIFICATE**  
Filing Requirement of Act 74, Mich. P.A. 1970

For corners in

INGHAM COUNTY Located In: Corner Code #  
(County)  
LEROY TOWNSHIP  
1. Public Land Survey T 3N R 2E M-11  
T R  
T R  
T R  
2. Property Controlling S T  
in Section S T R  
3. Miscellaneous T R  
Property in Sec. S T R  
4. Lot No. , Recorded Plat  
5. Private Claims



1999-050550  
Page: 1 of 1  
10/08/1999 02:29P

Register of Deeds Stamp & File Number

I, DAVID L. CLIFFORD, in a field survey on APRIL 6, 1999 Do hereby state that under requirements of P.A. 74, Michigan P.A. of 1970, the corner points mentioned in lines 1 and 2 above were in conformance with regulations and rules therefore as required in the current manual of survey instructions of the United States Department of the Interior, Bureau of Land Management or by a decree of a Court of Law and/or that the corner points mentioned in lines 3, 4 and 5 above were in conformance with the rules of the Michigan Board of Land Surveyors or by a Decree of a Court of Law, established, re-established, monumented, recovered, found as expressed below.

**NOTE:** Not more than 2 corners, all in the same town and range, may be recorded on this certificate.

A	B	C	D	E	F	G	H	I	J	K	L	M
1												
2	6	5	4	3	2	1						
3												
4	7	8	9	10	11	12						
5												
6	18	17	16	15	14	13						
7												
8	19	20	21	22	23	24						
9												
10	30	29	28	27	26	25						
11												
12	31	32	33	34	35	36						
13												

A. Description of original monument and accessories and/or subsequent restoration:


1. ORIGINAL POST SET BY JOSEPH WAMPLER DS IN DEC. 1824; ELM 20 S10½W 328, ASPEN 18 N68½E 245
2. TJ BROWN, COUNTY SURVEYOR, USED CORNER IN A SURVEY RECORDED IN VOLUME 2 PAGE 368, INGHAM COUNTY SURVEYOR RECORDS IN JAN. 1860 WITH NO MENTION OF MONUMENT AND THE FOLLOWING WITNESSES; ELM 20" S10½W 328 LKS; DO. 22" S7½E 291¼ LKS;
3. WA ROWE, COUNTY SURVEYOR, USED CORNER IN A SURVEY RECORDED IN VOLUME 3 PAGE 240, INGHAM COUNTY SURVEYOR RECORDS IN AUG. 1895 AS A BUGGY AXLE; S. OAK 18" N43½E 428 LKS; HICK. 10" S11E 283 LKS;
4. AN EXCAVATION CREW FROM THE INGHAM COUNTY REMONUMENTATION PROJECT OF THE LATE 1970'S UNDER THE SUPERVISION OF LARRY BRYAN RLS #25832 EXCAVATED A HOLE 10' X 10' X 4' DEEP ON OCT. 13, 1978 AND FOUND A 1/2" BAR & CAP # 14762 (C. GARLOCK). EXCAVATION WAS STOPPED PENDING NOTIFICATION OF C. GARLOCK AND MORE INFORMATION SUCH AS DISTANCES, LOCATION OF DITCH TO NORTH AND POSSIBILITY THAT EXCAVATION WAS ON PRIVATE PROPERTY.
5. AN INQUIRY BY OLD REMONUMENTATION PERSONEL TO CHARLIE GARLOCK WAS ANSWERED BY MR. GARLOCK WITH A NOTE STATING THAT BAR & CAP WAS REFERENCE IRON TO SW CORNER SECTION 30 HANDY TOWNSHIP, LIVINGSTON CO. MI.
6. C. GARLOCK RLS #14762 RECORDED CORNER LIBER 9 OF CORNERS PAGE 69 IN NOV. 1996 AS A FOUND 1/2" BAR & CAP; NORTH, 18.75' SP. W/S 14" MAPLE; S05°E, 9.00' SP W/S 48" MULTI. (4) MAPLE; NW, 56.87' SP S/S 30" MAPLE; SOUTH, 82.40', 1/2" IRON ROD (SW CORNER OF SEC. 30, T3N-R3E, HANDY TOWNSHIP)
7. DARRELL HUGHES RLS #19834 USED CORNER IN AN UNRECORDED SURVEY IN DEC. 1983 AS A FOUND 1/2" IRON ROD M&G CAP # 14762; NAIL & TAG WEST SIDE MULT. TRUNK MAPLE, 153°, 8.99'; NAIL & TAG SOUTH SIDE 30" MAPLE, 292°, 56.93 FT.; NAIL & TAG NW SIDE 12" DBL. TRUNK TREE, 240°, 68.89 FT.; 1/2" REROD (NW CORNER SEC. 31 T3N, R3E), 183°, 82.46 FT.

B. Description of corner evidence found and/or method applied in restoring or reestablishing corner:

SEARCHED AT APPARENT LOCATION OF CORNER AND FOUND A 1/2" BAR & CAP # 14762 AT INTERSECTION KANE ROAD TO SOUTH & DENNIS ROAD TO NORTH MATCHING GARLOCK'S AND HUGHES WITNESSES. SEARCHED AREA IN 30' DIAMETER CIRCLE WITH METAL DETECTOR AND GOT STRONG READING 10' NORTHWEST OF FOUND IRON. EXCAVATED 3' DIAMETER BY 3' DEEP HOLE AND FOUND BENT BUGGY AXLE. EXCAVATED AROUND BUGGY AXLE UNTIL IT WAS STRAIGHT. STRAIGHTENED AXLE AND ACCEPTED IT AS CORNER AS PERPETUATED BY WA ROWE AND STAMPED 25837 IN TOP.

C. Description of monument for corner and accessories established to perpetuate locating the position of the corner:

- M-11 T3N-R2E
- 3/4 " DIAMETER BUGGY AXLE WITH 1½" HEAD STAMPED 25837 AT 90° BEND IN KANE & DENNIS ROADS
- FOUND NAIL & TAG #19834 IN WEST SIDE 25" MAPLE, S42°E, 19.50'
- FOUND NAIL & TAG #19834 IN SOUTH SIDE 30" MAPLE, N73°W, 47.17'
- SET NAIL & TAG #25837, WEST SIDE 15" OAK, S23°W, 94.27'
- FOUND NAIL NORTH SIDE 40" MAPLE, S22°E, 110.45'
- 1/2" BAR & CAP #14762, S43° E, 10.78'
- 1/2" BAR (A-11 HANDY TOWNSHIP AS RECORDED IN LIBER 2 PAGE 345 LIVINGSTON COUNTY RECORDS), S03°E, 90.25'

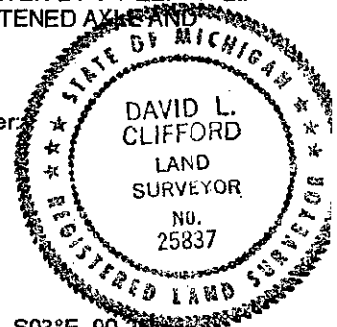

Signed by David Clifford  
Surveyor's Michigan License No. 25837

Date JUNE 12, 1999