

**SURVEY & REMONUMENTATION**

DEC 1 6 1996

Liber 8 Page 621

For corners in **COMMISSION**

**LAND CORNER RECORDATION CERTIFICATE**  
**Filing Requirement of Act 74, Mich. P.A. 1970**  
**WILLIAMSTOWN TOWNSHIP**

**FILED**

960034292  
 09/06/1996 13:18:26  
 REGISTER OF DEEDS  
 Paula Johnson  
 INGHAM COUNTY, MI

INGHAM (County) Located In: Corner Code ##


1. Public Land Survey T 4N R 1E C-11  
 T R  
 T R  
 T R

2. Property Controlling S T R  
 in Section S T R

3. Miscellaneous S T R  
 Property in Sec. S T R

4. Lot No. \_\_\_\_\_, Recorded Plat \_\_\_\_\_

5. Private Claims \_\_\_\_\_

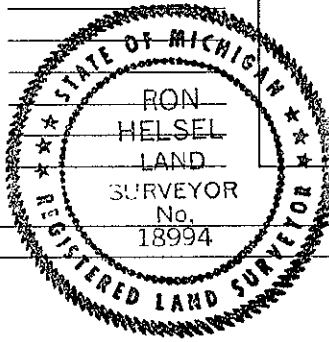

Register of Deeds Stamp & File Number

	A	B	C	D	E	F	G	H	I	J	K	L	M
2	6		5		4		3		2		1		
3													
4	7		8		9		10		11		12		
5													
6	13		17		16		15		14		13		
7													
8	19		20		21		22		23		24		
9													
10	30		29		28		27		26		25		
11													
12	31		32		33		34		35		36		
13													

I, RON HELSEL, in a field survey on MAY 22, 1996, do hereby certify that under requirements of P.A. 74, Michigan P.A. of 1970, the corner points mentioned in lines 1 and 2 above were in conformance with regulations and rules therefore as required in the current manual of survey instructions of the United States Department of the Interior, Bureau of Land Management or by a decree of a Court of Law and/or that the corner points mentioned in lines 3, 4 and 5 above were in conformance with the rules of the Michigan Board of Land Surveyors or by a Decree of a Court of Law; established, re-established, monumented, re-monumented, recovered, found as expressed below:

**NOTE: Not more than 4 corners, all in the same town and range, may be recorded on this certificate.**

- A. Description of original monument and accessories and/or subsequent restoration:  
 ORIGINAL MONUMENT POST SET BY J. WAMPLER, U.S. DEPUTY SURVEYOR, MARCH 1826.  
 SET 80.00 CHAINS  
 IRONWOOD 5" N79°W, 7 LINKS  
 BEECH 22" N1 1/2E, 20 LINKS  
 2.14 CHAINS TO A-11 (PRINCIPAL MERIDIAN)  
 DID NOT FIND FURTHER EVIDENCE OF COUNTY SURVEYOR OR PUBLIC SURVEYS REFERENCED TO THIS CORNER.
- B. Description of corner evidence found and/or method applied in restoring or reestablishing corner:  
 TRAVERSED TO FIND PROBABLE AREA OF CORNER. EXCAVATED A BOLT APPROXIMATELY 8' EAST OF THE PRORATED G.L.O. DISTANCE BETWEEN D-11 AND A-11. THE AREA WAS A CUT ABOUT 5 FEET ON THE NORTH SIDE AND ABOUT 3 FEET ON THE SOUTH SIDE OF TURNER ROAD. DEEMED THE CORNER AS LOST AND THE BOLT AS SOMETHING DROPPED OFF MACHINERY. SINCE SECTION 31 IS A FRACTIONAL SLIVER SECTION AND OWNER-SHIP ALONG BOTH SIDES OF THE LINE NORTH & SOUTH HAS BEEN INCLUDED IN DEEDS AS CONTINUOUS PARCELS, SET A 3/4" FORM PIN WITH LABELED P.A. 345 AT THE PRORATED DISTANCE BETWEEN (D-11) AND (A-11) TO CONFORM WITH COUNTY SURVEYOR W.H. RAYNOR, VOL. 3, PAGE 229, JUNE 13, 1894, IN WHICH HE DID THE SAME ALONG THE EAST-WEST 1/4 LINE OF SECTION 32.
- C. Description of monument for corner and accessories established to perpetuate locating the position of the corner:  
 3/4" FORM PIN IN MON. BOX 3.0 FEET NORTH CENTERLINE OF TURNER ROAD WEST, 140.88' TO A-11 (NW COR. SEC. 31)  
 EAST, 2640.52' TO D-11 (NORTH 1/4 COR. SEC. 32)  
 SET NAIL & TAG NO. 18994 NE/SIDE 18" CHERRY, AZ. 289°, 75.03'  
 SET NAIL & TAG NO. 18994, SW/SIDE 8" ASH, AZ. 333°, 25.39'  
 SET NAIL & TAG NO. 18994 S/SIDE MAPLE CLUMP, AZ. 41°, 44.42'  
 SET NAIL & TAG NO. 18994 N/SIDE POWER POLE, AZ. 107°, 142.55'

Signed by Ron Helsel Date Aug. 15, 1996  
 Surveyor's Michigan License No. 18994