

DEC 1 1996

COMMISSION

LAND CORNER RECORDATION CERTIFICATE  
Filing Requirement of Act 74, Mich. P.A. 1970  
WILLIAMSTOWN TOWNSHIP

Liber 9 Page 2


For corners in

INGHAM  
(County)

Located in:

Corner Code ##

- 1. Public Land Survey T 4N R 1E C-12
- T R
- T R
- T R
- 2. Property Controlling S T R
- in Section S T R
- 3. Miscellaneous S T R
- Property in Sec. S T R
- 4. Lot No. \_\_\_\_\_, Recorded Plat \_\_\_\_\_
- 5. Private Claims \_\_\_\_\_

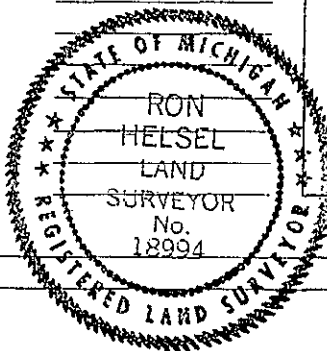

FILED

960037631  
10/01/1996 11:13:24  
REGISTER OF DEEDS  
Paula Johnson  
INGHAM COUNTY, MI

Register of Deeds Stamp & File Number

	A	B	C	D	E	F	G	H	I	J	K	L	M
2	6		5		4		3		2		1		
3													
4	7		8		9		10		11		12		
5													
6	18		17		16		15		14		13		
7													
8	19		20		21		22		23		24		
9													
10	30		29		28		27		26		25		
11													
12	31		32		33		34		35		36		
13													

I, RON HESSEL, in a field survey on SEPT. 12, 19 96, do hereby certify that under requirements of P.A. 74, Michigan P.A. of 1970, the corner points mentioned in lines 1 and 2 above were in conformance with regulations and rules therefore as required in the current manual of survey instructions of the United States Department of the Interior, Bureau of Land Management or by a decree of a Court of Law and/or that the corner points mentioned in lines 3, 4 and 5 above were in conformance with the rules of the Michigan Board of Land Surveyors or by a Decree of a Court of Law; established, re-established, monumented, re-monumented, recovered, found as expressed below:

NOTE: Not more than 4 corners, all in the same town and range, may be recorded on this certificate.

A. Description of original monument and accessories and/or subsequent restoration:  
 ORIGINAL MONUMENT: POST SET BY JOSEPH WAMPLER, U.S. DEPUTY SURVEYOR, MARCH, 1826 SET 40.00 CHAINS. BEECH 11", N66W, 6 1/2 LINKS  
 BEECH 15", S80E, 35 LINKS  
 1) VOL 3, PAGE 229, COUNTY SURVEYOR W.H. RAYNER ON JUNE 13, 1894, IGNORED THIS CORNER IN A SURVEY ALONG THE E-W 1/4 LINE RUNNING THE LINE BETWEEN A-12 (PRINCIPAL MERIDIAN) AND THE CENTER OF SECTION 32. SEC. 31 OF WILLIAMSTOWN IS A SLIVER SECTION AND OWNERSHIP OF LAND NORTH & SOUTH OF THE 1/4 LINE HAS BEEN CONTINUOUS.  
 CONTINUED ON BACK

B. Description of corner evidence found and/or method applied in restoring or reestablishing corner:  
 DEEMED THIS CORNER OBLITERATED & SET A 3/4" BY 24" STEEL MARKER AT THE INTERSECTION OF THE EAST-WEST 1/4 LINE OF SECTION 31 & 32. ESTABLISHED AS A LINE BETWEEN A-12 (PRINCIPAL MERIDIAN) AND D-12 (CENTER OF SECTION 32) AND THE LINE BETWEEN SECTIONS 31 & 32, ESTABLISHED BY C-11 & C-13, TO CONFORM WITH THE SURVEY BY W.H. RAYNER IN 1-A ABOVE.

C. Description of monument for corner and accessories established to perpetuate locating the position of the corner:  
 3/4" X 24" FORM PIN AND CAP LABELED P.A. 345, P.S. NO. 18994. 334'± EAST OF THE CENTERLINE OF MERIDIAN ROAD AND NEAR THE SOUTH ROW OF SWALLOW TAIL DRIVE.  
 CORNER C-13 AZ. 176°, 2629.68'  
 CORNER A-12 AZ. 270°, 344.08'  
 CORNER D-12 AZ. 90°, 2637.70'  
 CORNER C-11 AZ. 356°, 2652.23'  
 SET NAIL & TAG NO. 18994 S/SIDE POWER POLE AZ. 269°, 129.15'  
 CONC. MONUMENT ON SOUTH ROW OF SWALLOW TAIL LANE AZ. 270°37'40", 33.90'  
 CONC. MONUMENT ON NORTH ROW OF SWALLOW TAIL LANE AZ. 332°52'35", 74.59'  
 CENTERLINE CATCH BASIN N/SIDE SWALLOW TAIL LANE AZ. 48°46'05", 270.63'  
 CENTERLINE CATCH BASIN S/SIDE SWALLOW TAIL LANE AZ. 57°22'45", 289.24'

Signed by Ron Hesel Date SEPT. 18, 1996

Surveyor's Michigan License No. 18994

P.A. 345 INGHAM COUNTY

PEER APPROVED 9/19/96 PL

"A" CONTINUED

- 2) DID NOT FIND FURTHER MENTION IN PUBLIC OR PRIVATE RECORDS.
- 3) APPARENTLY A BOUNDARY SURVEY WAS MADE BY A. WILLIAMS NO. 21275 ON THE AREA BETWEEN THE E-W 1/4 LINE AND THE NORTH R.O.W. LINE OF THE R.R. TO THE SOUTH, (WHAT IS RECORDED AS BAAN.GAN.AKA SITE CONDOMINIUM). NO SURVEY DOCUMENTS ARE AVAILABLE.

RECORDED  
INDEXED  
